

PANOLA MISSISSIPPI BOARD OF WATER COMMISSIONERS

S  
12-17-65

WATER WELL DRILLERS LOG

Date 12-17, 1965, Driller: Garry Roberson County Panola  
(Name)

(1) Owner of Land: Mr. G. B. Barnett  
(Name)  
Batonville, Miss  
(Address)

(2) Location: 1/4, 1/4, Sec.      T.      R.       
8 miles E of B'ville  
(distance) (direction) (Nearest Town)

(3) Topography: V  
(Hilly) (Flat) (Level)

(4) Purpose of Well: None  
(Domestic Irrigation  
Municipal, Industrial, Other)

Description & Color of Materials Sand, Clay, Red Clay, Shell, etc.	Thick- ness Feet	Depth Feet
<u>Clay</u>	<u>0</u>	<u>10</u>
<u>Clay &amp; Rock</u>	<u>10</u>	<u>20</u>
<u>Gravel</u>	<u>20</u>	<u>50</u>
<u>Sand &amp; Clay</u>	<u>50</u>	<u>100</u>
<u>Gravel</u>	<u>100</u>	<u>110</u>
<u>Sand &amp; Clay</u>	<u>110</u>	<u>130</u>
<u>Clay</u>	<u>130</u>	<u>150</u>
<u>Sand</u>	<u>150</u>	<u>160</u>

Information upon completion of well:

(1) Diameter 4 inches.

(2) Total Depth 180 feet.

(3) Water Level 55 feet below top of ground.


(4) Cased to 145, Size 4in.

(5) Screen: Size 3in, Length 5ft.

(6) Were any formations sealed against pollution?  
\_\_\_\_\_ yes, \_\_\_\_\_ no.

If YES depth of formation \_\_\_\_\_  
Why \_\_\_\_\_

Drillers Remarks: Plastic well  
Inside screen

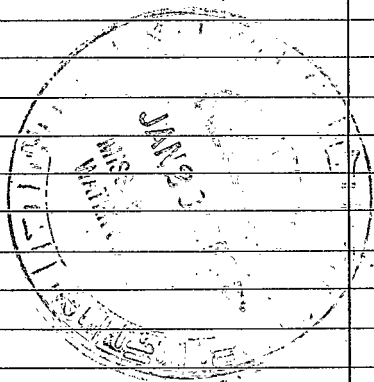

(Use Back Side)

Well No.

