

PANOLA
S

MISSISSIPPI BOARD OF WATER COMMISSIONERS

1-6-66

WATER WELL DRILLERS LOG

Date: 1-6, 1966, Driller: J B Cain County: Panola

(Name)

(1) Owner of Land: Mr. Tranel
(Name)

(Address)

(2) Location: 1/4, 1/4, Sec. T R

10 miles E of Batesville
(distance) (direction) (Nearest Town)

(3) Topography: (Hilly) (Flat) (Level)

(4) Purpose of Well: Flame
(Domestic Irrigation Municipal, Industrial, Other)

Description & Color of Materials
Sand, Clay, Red Clay, Shell, etc.

Thick-
ness
Feet

Depth
Feet

clay 0 30
Sand & clay 30 50
Sand 50 95

Information upon completion of well:

(1) Diameter 2 inches.

(2) Total Depth 95 feet.

(3) Water Level 75 feet below top of ground.

(4) Cased to 95, Size 2"

(5) Screen: Size 3 Shorewell, Length 5 FT

(6) Were any formations sealed against pollution?


yes, no.

If YES depth of formation

Why

Drillers Remarks: 2" Plastic Well

2 level pack screen

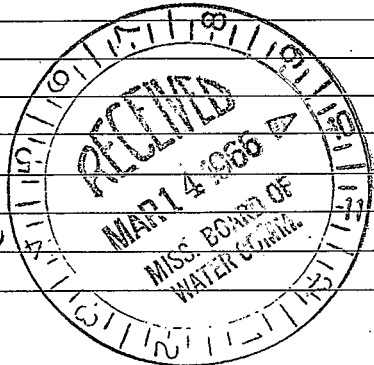

(Use Back Side)

Well No.

