

PANOLA
SI
2-3-71

MISSISSIPPI
BOARD OF WATER COMMISSIONERS
416 North State Street
Jackson, Mississippi 39201

CODED

WATER WELL DRILLERS LOG

Feb 3 1971 J. B. Cain PANOLA
date well completed firm name county well located

LANDOWNER: Richard Appleton

description of formations encountered	from	to
RED CLAY	0	10
RED SAND	10	50
PINK CLAY	50	70
GRAVEL	70	110
ROCK	110	111
BLUE CLAY	111	170
WATER SAND	170	180
BLUE CLAY	180	248
WATER SAND	248	275

(mailing address)

WELL LOCATION:

sec 16 T 9 N R 6 E
miles _____ of _____
(distance) (direction) (nearest town)

WELL PURPOSE: HOME
(home, irrigation, municipal, industrial)

WELL COMPLETION DATA:

- (1) diameter (inches) 4"
- (2) total depth (feet) 275
- (3) static water level (feet) 140 below above top of ground.
- (4) casing Plastic, 275,
(material) (depth)
4"
(size) If telescope see back.
- (5) screen 2", 275
(length) (depth to top)
4"
(size) (material)
- (6) pump 3 (yield gpm)
HP
220
(type power)
- (7) electric log NO
(yes or no)

(organization running log)
- (8) how well bottom plugged wash better

CODED


APR - 6 1971

MISS. BD. OF
WATER COMMISSIONERS

DRILLERS REMARKS:

If well telescopes please sketch and show depths.

GROUND LEVEL

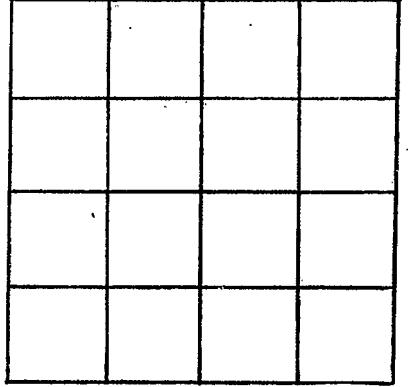

SECTION _____

Please indicate well location X.

ADDITIONAL INFORMATION

If more than one screen,
show locations of each on sketch.