

PANOLA
S3
12-2-71

MISSISSIPPI
 BOARD OF WATER COMMISSIONERS
 416 North State Street
 Jackson, Mississippi 39201

DEC 20 1971

CODED

WATER WELL DRILLERS LOG

Dec 2 1971 LIPE WELL CO. PANOLA CO.
 date well completed firm name county well located

LANDOWNER:	description of formations encountered	from	to
Poloren, Inc.	top soil	0	10
Batesville	white clay	10	15
(mailing address)	yellow clay	15	25
	sand	25	166

WELL LOCATION:
 sec. 15 T. 9 N R. 6 E
 0 miles 0 of Batesville
 (distance) (direction) (nearest town)

WELL PURPOSE: INDUSTRIAL
 (home, irrigation, municipal, industrial)


- WELL COMPLETION DATA:
- (1) diameter (inches) 4"
 - (2) total depth (feet) 106'
 - (3) static water level (feet) 20 ^{below} top of ground.
 - (4) casing PVC 98' (material) (depth)
 4" (size) If telescope see back.
 - (5) screen 8 98' (length) (depth to top)
 4" (size) PVC & silica (material)
 - (6) pump 2 20 (HP) (yield gpm)
 elec. (type power)
 - (7) electric log no (yes or no)
 (organization running log)
 - (8) how well bottom plugged PVC cap

CODED

DRILLERS REMARKS:

If well telescopes please sketch and show depths.

GROUND LEVEL

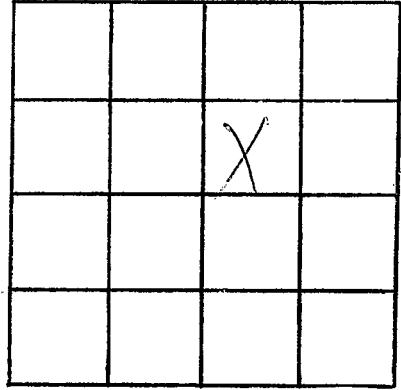

SECTION 15

Please indicate well location X.

ADDITIONAL INFORMATION

Lined area for additional information.

If more than one screen, show locations of each on sketch.