

Notwood

PANOLA
54
9-25-71

MISSISSIPPI
BOARD OF WATER COMMISSIONERS
416 North State Street
Jackson, Mississippi 39201

WATER WELL DRILLERS LOG

CODED

9-25 date well completed 71 JB Cain firm name Notwood county well located

LANDOWNER: Mr Notwood

description of formations encountered	from	to
Sandy Clay	0	80
Red Shale	80	100
Water Sand	100	115

(mailing address)

WELL LOCATION:

sec. 17 T 9 N R 6 E
6 miles E of Batesville

WELL PURPOSE: Home
(home, irrigation, municipal, industrial)

WELL COMPLETION DATA:

- (1) diameter (inches) 4"
- (2) total depth (feet) 115'
- (3) static water level (feet) 95' below top of ground.
- (4) casing PLASTIC 115'
(material) (depth)
- (size) If telescope see back.
- (5) screen 10' 105'
(length) (depth to top)
- 4" SLOT PLASTIC
(size) (material)
- (6) pump 1/2 HP 125
(HP) (yield gpm)
- Elec -
(type power)
- (7) electric log No
(yes or no)

CODED

(organization running log)

(8) how well bottom plugged Plog


MAY 25 1971

DRILLERS REMARKS:

MISS. Bd. OF
WATER COMMISSIONERS

If well telescopes please sketch and show depths.

GROUND LEVEL

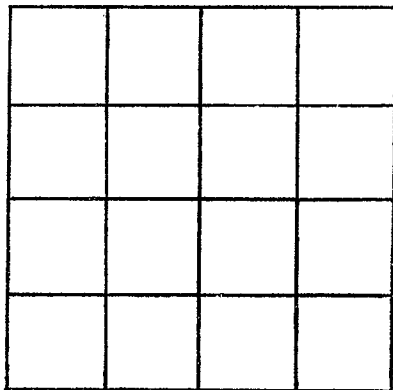

SECTION _____

Please indicate well location X.

ADDITIONAL INFORMATION

If more than one screen, show locations of each on sketch.