

MISSISSIPPI
BOARD OF WATER COMMISSIONERS
416 North State Street
Jackson, Mississippi 39201

CODED

PANOLA
S 7
10-6-72

WATER WELL DRILLERS LOG

10-6 1972 JAMES B. LIPPE Panola
date well completed firm name county well located

LANDOWNER: Horace Henderson
Batesville
MISS.
(mailing address)

description of fomations encountered	from	to
	Clay	0
IC	20	40
sand	40	80
Clay	80	100
sand	100	120
	120	193

WELL LOCATION:
sec. 30 T 9 N R 6 E
8 miles East of Batesville
(distance) (direction) (nearest town)

WELL PURPOSE: Home
(home, irrigation, municipal, industrial)

CODED


- WELL COMPLETION DATA:
- (1) diameter (inches) 4
 - (2) total depth (feet) 195
 - (3) static water level (feet) 110 below above top of ground.
 - (4) casing PVC, 185
(material) (depth)
4 if telescope see back.
(size)
 - (5) screen 10', 185
(length) (depth to top)
4, PVC
(size) (material)
 - (6) pump 3/4, 12
(HP) (yield gpm)
Elec.
(type power)
 - (7) electric log no
(yes or no)
no
(organization running log)
 - (8) how well bottom plugged PVC
PVUg

DRILLERS REMARKS:

NOV 1 1972
MISS. BU. OF
WATER

If well telescopes please sketch and show depths.

GROUND LEVEL

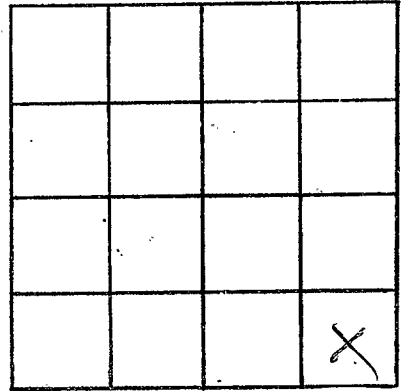

SECTION 30

Please indicate well location X.

ADDITIONAL INFORMATION

If more than one screen,
show locations of each on sketch.