

MISSISSIPPI
BOARD OF WATER COMMISSIONERS
416 North State Street
Jackson, Mississippi 39201

CODED

PANOLA
58
10-16-72

WATER WELL DRILLERS LOG

10-16-72 date well completed 1972 James R. Lipe firm name Panola county well located

LANDOWNER: Bill Rhine
Batesville
Miss.
(mailing address)

description of formations encountered	from	to
Red sand	0	20
" "	20	40
clay and sand	40	60
" "	60	80
black clay	80	100
" "	100	120
sand	120	143

WELL LOCATION:
sec. 32 T 9 N R. 6 E
10 miles East of Batesville
(distance) (direction) (nearest town)

WELL PURPOSE: HOME
(home, irrigation, municipal, industrial)

WELL COMPLETION DATA:

(1) diameter (inches) 4

(2) total depth (feet) 143

(3) static water level (feet) 90 below above top of ground.

(4) casing PVC, 133,
(material) (depth)
4 if telescope see back.
(size)

(5) screen 10, 133
(length) (depth to top)
4, PVC
(size) (material)

(6) pump 3/4, 10
(HP) (yield gpm)
Elec.
(type power)

(7) electric log no
(yes or no)
no
(organization running log)

(8) how well bottom plugged PVC
plug


DRILLERS REMARKS:

NOV - 1 1972

MISS. Bd. of
WATER COMMISSIONERS

If well telescopes please sketch and show depths.

GROUND LEVEL

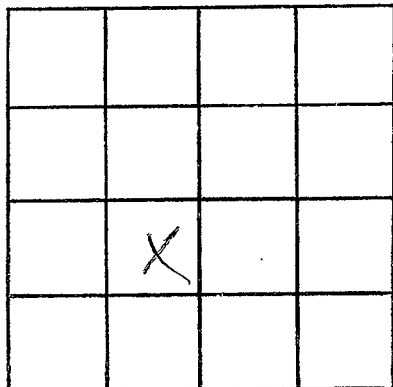

SECTION 52

Please indicate well location X.

ADDITIONAL INFORMATION

If more than one screen, show locations of each on sketch.