

PANOLA  
 S10  
 11-14-72

MISSISSIPPI  
 BOARD OF WATER COMMISSIONERS  
 416 North State Street  
 Jackson, Mississippi 39201

WATER WELL DRILLERS LOG **CODED**

11-14 date well completed      1972 James R. Lipe firm name      Panola county well located

LANDOWNER: TIM Henson  
Courtland  
Miss.  
 (mailing address)

WELL LOCATION:  
 sec. 27 T 9 N. R. 6 E  
6 miles E of Courtland  
 (distance) (direction) (nearest town)

WELL PURPOSE: HOME  
 (home, irrigation, municipal, industrial)

- WELL COMPLETION DATA:
- (1) diameter (inches) 4
  - (2) total depth (feet) 163
  - (3) static water level (feet) 90 below above top of ground.
  - (4) casing PVC, 153,  
 (material) (depth)  
4 if telescope see back.  
 (size)
  - (5) screen 10, 163.  
 (length) (depth to top)  
4, PVC  
 (size) (material)
  - (6) pump 3/4, 10  
 (HP) (yield gpm)  
Elec.  
 (type power)
  - (7) electric log NO  
 (yes or no)  
NO  
 (organization running log)
  - (8) how well bottom plugged PVC PLUG

description of formations encountered	from	to
clay	0	20
sand	20	40
sand and gravel	40	60
clay	60	80
"	80	100
"	100	120
sand and clay	120	140
sand	140	160
clay	160	163


**CODED**

DEC 28 1972

DRILLERS REMARKS:

If well telescopes please sketch and show depths.

GROUND LEVEL

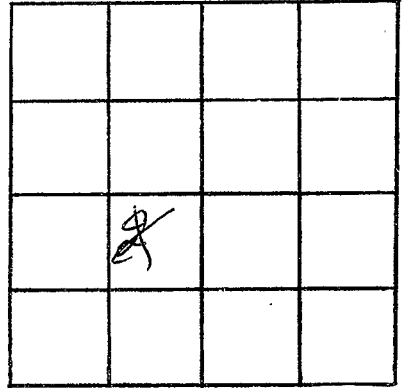

SECTION 27

Please indicate well location X.

ADDITIONAL INFORMATION

If more than one screen,  
show locations of each on sketch.