

R 519

12-16-62

WATER WELL DRILLERS LOG

CODED

Date: 12-16, 1962

Driller: James R. Lipo

County: Panola (Name)

(1) Owner of Land:	Description & Color of Materials Sand, Clay, Red Clay, Shell, etc.	Thick- ness Feet	Depth Feet
(Name) <u>Joe Ellis</u> <u>Batesville, Miss</u> (Address)	<u>Sand</u> <u>SAND & CLAY</u> <u>W/Gravelly Sand</u>	<u>0</u> <u>30</u> <u>75</u>	<u>30</u> <u>75</u> <u>104</u>
(2) Location: <u>1/4</u> , <u>1/4</u> , Sec. <u>16</u> T <u>9</u> R <u>6</u> W <u>5</u> <u>7</u> miles <u>east</u> of <u>Batesville</u> (distance) (direction) (Nearest Town)			
(3) Topography: <u>Hills</u> (Hilly) (Flat) (Level)			
(4) Purpose of Well: <u>Dom.</u> (Domestic Irrigation Municipal, Industrial, Other)			


Information upon completion of well:

- (1) Diameter 2' inches.
- (2) Total Depth 104 feet.
- (3) Water Level 60 feet below top of ground.
- (4) Cased to 98', Size 2"
- (5) Screen: Size 1 1/4, Length 6'
- (6) Were any formations sealed against pollution?
 yes, no.

If YES depth of formation _____

Why _____

Drillers Remarks: _____

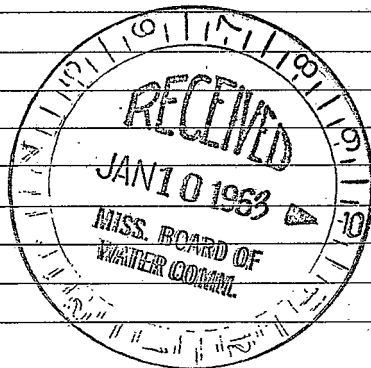

(Use Back Side)

Well No.

