

R.S. 21
2-18-64

CODED

WATER WELL DRILLERS LOG

Date: Feb 18, 1964, Driller: Frank ^{Lipe} Taylor County, Danville
(Name)

(1) Owner of Land: Ernest Horn
(Name)
Batesville
(Address)

(2) Location: 1/4, 1/4, Sec. 25-9 R 6
S W
10 miles S.E, of Batesville
(distance) (direction) (Nearest Town)

(3) Topography: Hilly
(Hilly) (Flat) (Level)

(4) Purpose of Well: Domestic
(Domestic Irrigation
Municipal, Industrial, Other)

Description & Color of Materials Sand, Clay, Red Clay, Shell, etc.	Thick- ness Feet	Depth Feet
<u>Clay</u>	<u>0</u>	<u>20</u>
<u>Clay & gravel</u>	<u>70</u>	<u>50</u>
<u>Open sand</u>	<u>50</u>	<u>55</u>
<u>Up sand</u>	<u>55</u>	<u>80</u>

Information upon completion of well:

(1) Diameter 2 inches.

(2) Total Depth 80 feet.

(3) Water Level 50 feet below top of ground.

(4) Cased to 70, Size 2


(5) Screen: Size 1/4, Length 6'

(6) Were any formations sealed against pollution?
_____ yes, _____ no.

If YES depth of formation _____

Why _____

Drillers Remarks: _____

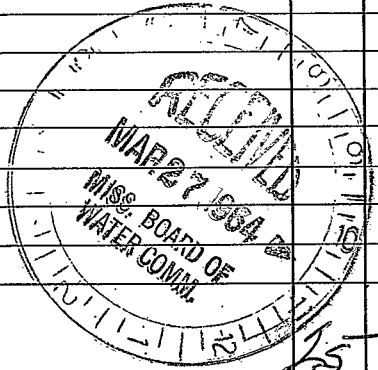

(Use Back Side)

Well No. 15

Handwritten text at the top of the page, possibly a header or title, which is mostly illegible due to fading and bleed-through.

Main body of handwritten text, consisting of several lines of cursive script. The text is very faint and difficult to decipher.

Handwritten text at the bottom of the page, including what appears to be a signature or a date, also largely illegible.