

CODED

MISSISSIPPI
BOARD OF WATER COMMISSIONERS
416 North State Street
Jackson, Mississippi 39201

WATER WELL DRILLERS LOG

Panola
526
6-5-69

June 5th 1969 date well completed
Robinson Well Drilling Co. firm name
Panola county well located

LANDOWNER: Harvey Morrison

description of formations encountered

from to

Batesville, Miss
(mailing address)

Red Clay + Sand
White Clay + "
Red clay
White sand

0 20
20 40
40 80
80 110

WELL LOCATION:

sec. 24 T 9 N R 6 E
13 miles SE of Batesville
(distance) (direction) (nearest town)

WELL PURPOSE: house
(home, irrigation, municipal, industrial)

WELL COMPLETION DATA:

- (1) diameter (inches) 4"
- (2) total depth (feet) 110
- (3) static water level (feet) 65 below above top of ground.
- (4) casing Plastic, 105'
(material) (depth)
4" if telescope see back.
(size)
- (5) screen 5 ft, 105'
(length) (depth to top)
4" gravel packed
(size) (material)
- (6) pump 3/4 12
(HP) (yield gpm)
220
(type power)
- (7) electric log 400
(yes or no)

(organization running log)

(8) how well bottom plugged Caped


DRILLERS REMARKS: Plastic
water well

OCT 22 1969

MISS. BD. OF
WATER COMML.

If well telescopes please sketch and show depths.

GROUND LEVEL

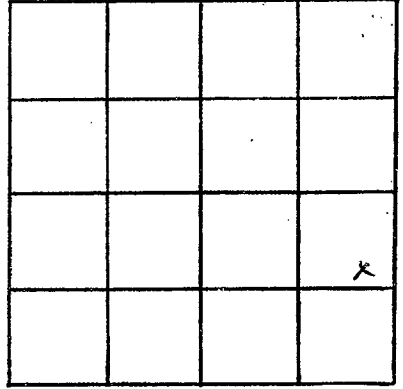

SECTION 24

Please indicate well location X.

ADDITIONAL INFORMATION

If more than one screen, show locations of each on sketch.