

PANOLA  
S 29  
10-29-70

MISSISSIPPI  
BOARD OF WATER COMMISSIONERS  
416 North State Street  
Jackson, Mississippi 39201

CODED

WATER WELL DRILLERS LOG

10-29 1970 James R. Lipe Panola  
date well completed firm name county well located

LANDOWNER: Cleo Chapman  
Batesville  
Miss.  
(mailing address)

description of formations encountered	from	to
Clay	0	20
11"	20	40
Sand	40	60
11"	60	80
Clay	80	100
Sand	100	120
Sand	120	142

WELL LOCATION:  
sec. 29 T. 9 N. R. 6 E.  
6 miles east of Batesville  
(distance) (direction) (nearest town)

WELL PURPOSE: Home  
(home, irrigation, municipal, industrial)

WELL COMPLETION DATA:

- (1) diameter (inches) 4
- (2) total depth (feet) 142
- (3) static water level (feet) 60 below above top of ground.
- (4) casing PVC 132 (material) (depth)  
(size) If telescope see back.
- (5) screen 10 132 (length) (depth to top)  
4 PVC (size) (material)
- (6) pump 3/4 8 (HP) (yield gpm)  
Elec (type power)
- (7) electric log NO (yes or no)

(organization running log)

(8) how well bottom plugged PVC Plug

DRILLERS REMARKS:


CODED

DEC 3 1970

MISS. BD. OF  
WATER COMMISSIONERS

If well telescopes please sketch and show depths.

GROUND LEVEL

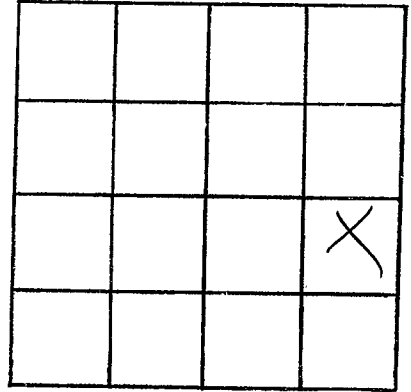

SECTION 29

Please indicate well location X.

ADDITIONAL INFORMATION

If more than one screen,  
show locations of each on sketch.