

PANOLA
S30
11-7-70

MISSISSIPPI
BOARD OF WATER COMMISSIONERS
416 North State Street
Jackson, Mississippi 39201

CODED

WATER WELL DRILLERS LOG

11-7 1970 James R Lipe Panola
date well completed firm name county well located

LANDOWNER: Marie wright

Batesville

Miss.
(mailing address)

WELL LOCATION:

sec 29 T 9 N R 6 E
6 miles east of Batesville
(distance) (direction) (nearest town)

description of formations encountered

from to

Top Soil	0	20
Clay	20	40
Sand	40	60
LC	60	80
Clay	80	100
Sand	100	120
LC	120	132

WELL PURPOSE: HOME
(home, irrigation, municipal, industrial)

WELL COMPLETION DATA:

- (1) diameter (inches) 4
- (2) total depth (feet) 132
- (3) static water level (feet) 70 below top of ground.
- (4) casing PVC 122 (material) (depth)
If telescope see back.
(size)
- (5) screen 10 122 (length) (depth to top)
4 PVC (size) (material)
- (6) pump 3/4 8 (HP) (yield gpm)
Elec. (type power)
- (7) electric log NO (yes or no)

CODED

DEC 3 1970

(organization running log)


MISS. BD. OF
WATER COMM.

(8) how well bottom plugged PVC Plug

DRILLERS REMARKS:

If well telescopes please sketch and show depths.

GROUND LEVEL

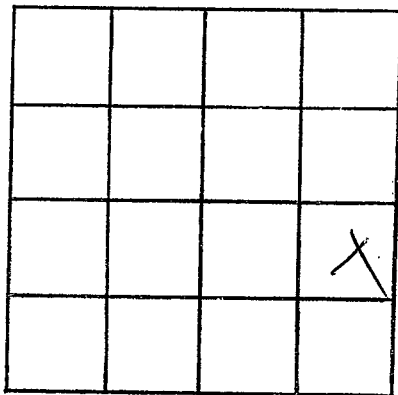

SECTION 29

Please indicate well location X.

ADDITIONAL INFORMATION

If more than one screen,
show locations of each on sketch.