

**PANOLA**  
**S 31**  
**1-20-70**

MISSISSIPPI  
 BOARD OF WATER COMMISSIONERS  
 416 North State Street  
 Jackson, Mississippi 39201

**CODED**

WATER WELL DRILLERS LOG

*Panola*

1-20  
 date well completed

19 *71* *James R. Lipe*  
 firm name

~~*Yalobusha*~~  
 county well located

LANDOWNER: *Tolie Morgan*  
*POPC Miss.*  
 (mailing address)

description of fomations encountered	from	to
	<i>Clay</i>	<i>0</i>
<i>Clay</i>	<i>20</i>	<i>40</i>
<i>Sand</i>	<i>40</i>	<i>60</i>
<i>Clay</i>	<i>60</i>	<i>80</i>
<i>Clay</i>	<i>80</i>	<i>100</i>
<i>Clay</i>	<i>100</i>	<i>120</i>
<i>sand</i>	<i>120</i>	<i>160</i>

WELL LOCATION:  
 sec *34* T *9* N R *6* E  
*8* miles *East* of *POPC*  
 (distance) (direction) (nearest town)

WELL PURPOSE: *HOME*  
 (home, irrigation, municipal, industrial)

- WELL COMPLETION DATA:
- (1) diameter (inches) *4*
  - (2) total depth (feet) *160*
  - (3) static water level (feet) *120* below above top of ground.
  - (4) casing *PVC 150*  
 (material) (depth)  
*4* if telescope see back.  
 (size)
  - (5) screen *10 150*  
 (length) (depth to top)  
*4 PVC*  
 (size) (material)
  - (6) pump *3/4 10*  
 (HP) (yield gpm)  
*Elec.*  
 (type power)
  - (7) electric log *No*  
 (yes or no)  
*No*  
 (organization running log)
  - (8) how well bottom plugged *PVC*  
*PIUG*

**CODED**


JAN 26 1971

DRILLERS REMARKS:

MISS. BD. OF  
 WATER COMMISSIONERS

If well telescopes please sketch and show depths.

GROUND LEVEL

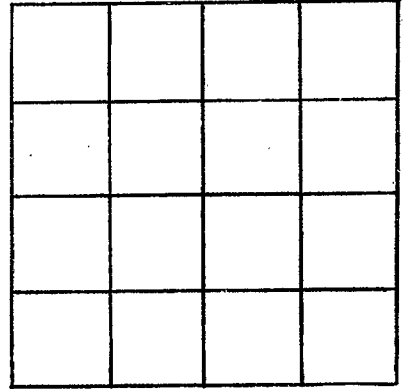

SECTION \_\_\_\_\_

Please indicate well location X.

ADDITIONAL INFORMATION

If more than one screen, show locations of each on sketch.