

MISSISSIPPI  
 BOARD OF WATER COMMISSIONERS  
 416 North State Street  
 Jackson, Mississippi 39201

WATER WELL DRILLERS LOG **CODED**

Panola  
533  
3-67

3-2-67 1967 Robison & Son Panola  
 date well completed firm name county well located

LANDOWNER: John Miller  
241  
Anteville, Miss 38606  
 (mailing address)

description of formations encountered	from	to
<u>Clay &amp; gravel</u>	<u>0</u>	<u>40</u>
<u>fine gravel &amp; sand</u>	<u>40</u>	<u>80</u>
<u>white sand</u>	<u>80</u>	<u>100</u>


WELL LOCATION:  
 sec. 33 T. 9 N R. 6 E  
S W  
71 miles SE of Anteville  
 (distance) (direction) (nearest town)

WELL PURPOSE: Home  
 (home, irrigation, municipal, industrial)

- WELL COMPLETION DATA:
- diameter (inches) 3"
  - total depth (feet) 100 ft
  - static water level (feet) 85 below above top of ground.
  - casing Steel, 94 ft,  
 (material) (depth)  
3" if telescope see back.  
 (size)
  - screen 6 ft, 94 ft  
 (length) (depth to top)  
1/4, Brass  
 (size) (material)
  - pump Leakdown, 4  
 (HP) (yield gpm)  
210 2HP  
 (type power)
  - electric log yes  
 (yes or no)  
 (organization running log)
  - how well bottom plugged plugged


DRILLERS REMARKS: Steel water well

**CODED**

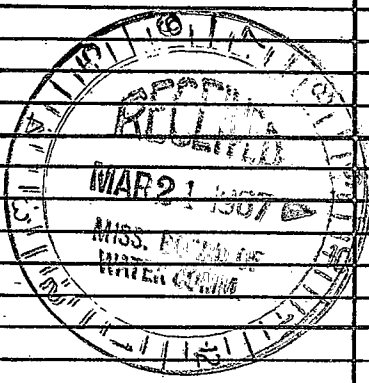

If well telescopes please sketch and show depths.

GROUND LEVEL

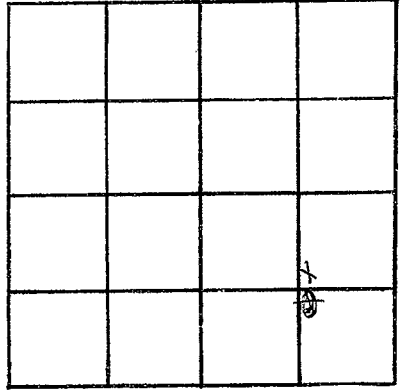

SECTION \_\_\_\_\_

Please indicate well location X.

ADDITIONAL INFORMATION

If more than one screen, show locations of each on sketch.