

MISSISSIPPI
BOARD OF WATER COMMISSIONERS
416 North State Street
Jackson, Mississippi 39201

WATER WELL DRILLERS LOG

CODED

Panola

534

3-67

3-8

1967

Roberson & Son

Panola

date well completed

firm name

county well located

LANDOWNER: Howard Morris

description of formations encountered

from

to

Pl 1

Batesville, Miss 38606
(mailing address)

Red Clay
Red Clay + Sand
Sand

0 10
20 40
40 55

WELL LOCATION:


sec. 20 T. 9 N R. 6 E
S W
0.7 miles SE of Batesville
(distance) (direction) (nearest town)

WELL PURPOSE: Home
(home, irrigation, municipal, industrial)

WELL COMPLETION DATA:

- (1) diameter (inches) 2"
- (2) total depth (feet) 55 ft
- (3) static water level (feet) 43 ft below above top of ground.
- (4) casing Steel, 48,
(material) (depth)
2" if telescope see back.
(size)
- (5) screen 7 ft, 48 ft
(length) (depth to top)
1/4, brass
(size) (material)
- (6) pump 1/2 rod pump, 2
(HP) (yield gpm)
110 2HP
(type power)
- (7) electric log no
(yes or no)
(organization running log)
- (8) how well bottom plugged plugged

CODED

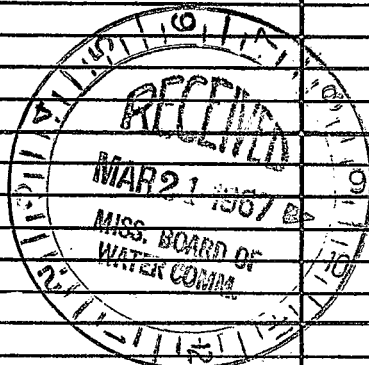


DRILLERS REMARKS: Steel

Water Well

If well telescopes please sketch and show depths.

GROUND LEVEL

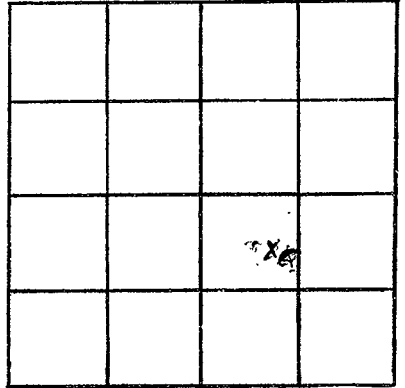

SECTION 20

Please indicate well location X.

ADDITIONAL INFORMATION

If more than one screen,
show locations of each on sketch.