

MISSISSIPPI
BOARD OF WATER COMMISSIONERS
416 North State Street
Jackson, Mississippi 39201

WATER WELL DRILLERS

CODED

Panola
535
3-67

3-11 1967 Roberson & Son Panola
date well completed firm name county well located

LANDOWNER: Jamie Rushing

description of formations encountered

from to

RT 1

Batesville, Miss
(mailing address)

Red Clay
Red Clay + Sand
Sea gravel + sand

0 20
20 40
40 80

WELL LOCATION:

sec. 20 T. 9 N R. 6 E
S W
7 1/2 miles SE of Batesville
(distance) (direction) (nearest town)

WELL PURPOSE: Home
(home, irrigation, municipal, industrial)

WELL COMPLETION DATA:


- (1) diameter (inches) 2"
- (2) total depth (feet) 80 ft
- (3) static water level (feet) 60 below above top of ground.
- (4) casing Steel, 73 ft.
(material) (depth)
2" if telescope see back.
(size)
- (5) screen 2 ft, 73 ft
(length) (depth to top)
1 1/4, brass
(size) (material)
- (6) pump 3/4 hp, 3
(HP) (yield gpm)
210 EVA
(type power)
- (7) electric log no
(yes or no)

CODED

(organization running log)


(8) how well bottom plugged plugged

DRILLERS REMARKS: Steel Water well

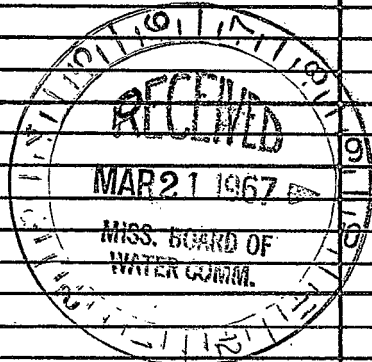

If well telescopes please sketch and show depths.

GROUND LEVEL

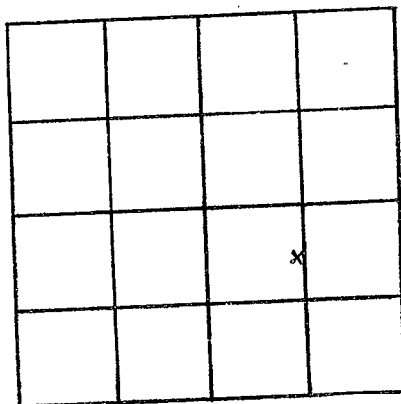

SECTION 20

Please indicate well location X.

ADDITIONAL INFORMATION

If more than one screen, show locations of each on sketch.