

Panola  
536  
3-67

MISSISSIPPI  
BOARD OF WATER COMMISSIONERS  
416 North State Street  
Jackson, Mississippi 39201

CODED

WATER WELL DRILLERS LOG

3-14 1967 Roberson & Son Panola  
date well completed firm name county well located

LANDOWNER: James Morris  
Pt 1  
Batesville, Miss 38606  
(mailing address)


description of formations encountered	from	to
<u>Red Clay &amp; sand</u>	<u>0</u>	<u>20</u>
<u>Red Clay</u>	<u>20</u>	<u>40</u>
<u>gravel &amp; sand</u>	<u>40</u>	<u>65</u>

WELL LOCATION:  
sec 30 T 9 N R 6 E  
S W  
7 3/4 miles SE of Batesville  
(distance) (direction) (nearest town)

WELL PURPOSE: Home  
(home, irrigation, municipal, industrial)

- WELL COMPLETION DATA:
- (1) diameter (inches) 2"
  - (2) total depth (feet) 65 ft
  - (3) static water level (feet) 50 below above top of ground.
  - (4) casing Steel, 58 ft,  
(material) (depth)  
2" if telescope see back.  
(size)
  - (5) screen 7 ft, 58 ft  
(length) (depth to top)  
1/4, Brass  
(size) (material)
  - (6) pump 1/4 and pump  
(HP) (yield gpm)  
no t.l.p.  
(type power)
  - (7) electric log no  
(yes or no)  
(organization running log)
  - (8) how well bottom plugged plugged


CODED

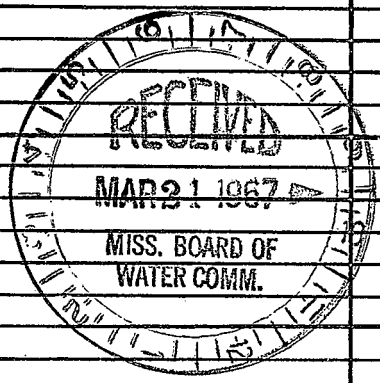

DRILLERS REMARKS: Steel water  
Well

If well telescopes please sketch and show depths.

GROUND LEVEL

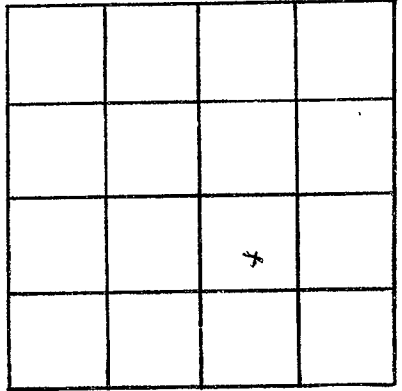

SECTION 30

Please indicate well location X.

ADDITIONAL INFORMATION

If more than one screen,  
show locations of each on sketch.