

Parola
537
9-67

MISSISSIPPI
 BOARD OF WATER COMMISSIONERS
 416 North State Street
 Jackson, Mississippi 39201

CODED

WATER WELL DRILLERS LOG

Sept 6 1967 Roberson & Son Parola
 date well completed firm name county well located

LANDOWNER: Bud Wendrix

description of formations encountered

from to

Batesville, Miss
 (mailing address)

<u>Red Clay</u>	<u>0</u>	<u>20</u>
<u>Red clay & sand</u>	<u>20</u>	<u>70</u>
<u>sand & gravel</u>	<u>40</u>	<u>80</u>
<u>sand & white clay</u>	<u>80</u>	<u>100</u>
<u>sand & blue clay</u>	<u>100</u>	<u>140</u>
<u>blue clay</u>	<u>140</u>	<u>200</u>
<u>white sand</u>	<u>200</u>	<u>220</u>

WELL LOCATION:
 sec. 18 T 9 N R 6 E
4 miles SE of B. Velle
 (distance) (direction) (nearest town)


WELL PURPOSE: home
 (home, irrigation, municipal, industrial)

WELL COMPLETION DATA:

- (1) diameter (inches) 2"
- (2) total depth (feet) 220
- (3) static water level (feet) 83 below top of ground.
- (4) casing plastic, 215'
 (material) (depth)
2" if telescope see back.
 (size)
- (5) screen 5', 215'
 (length) (depth to top)
3", gravel packed
 (size) (material)
- (6) pump 1 6
 (HP) (yield gpm)
FHP 110
 (type power)
- (7) electric log no
 (yes or no)
- (organization running log)
- (8) how well bottom plugged opened

CODED

DRILLERS REMARKS: Plastic
Water Well

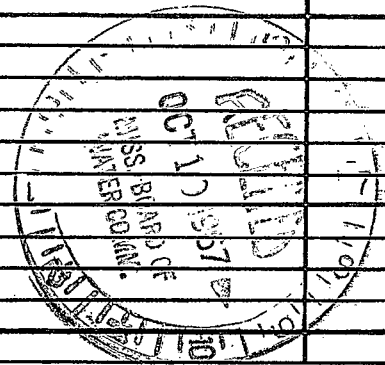

If well telescopes please sketch and show depths.

GROUND LEVEL

		X.	

SECTION 18

Please indicate well location X.

ADDITIONAL INFORMATION

If more than one screen,
show locations of each on sketch.