

Panola well
see
17 S38
11-67
0

MISSISSIPPI
 BOARD OF WATER COMMISSIONERS
 416 North State Street
 Jackson, Mississippi 39201

CODED

WATER WELL DRILLERS LOG

date well completed 19 11 - 1 67 firm name JBCAIN county well located PANOLA


LANDOWNER: Dubois Norwood
Courtland Miss
 (mailing address)

Description of formations encountered	from	to
<u>Red Clay</u>	<u>0</u>	<u>38</u>
<u>Sand & Gr</u>	<u>38</u>	<u>120</u>
<u>Blue Clay</u>	<u>120</u>	<u>290</u>
<u>Sand</u>	<u>290</u>	<u>350</u>

WELL LOCATION:
 sec. 17 T 9 N S R 6 W E W
6 miles E of BATESVILLE
 (distance) (direction) (nearest town)

WELL PURPOSE: Home
 (home, irrigation, municipal, industrial)

- WELL COMPLETION DATA:
- (1) diameter (inches) 4"
 - (2) total depth (feet) 350
 - (3) static water level (feet) 140 below top of ground.
 - (4) casing 4 Plastic 340
 (material) (depth)
 (size) if telescope see back.
 - (5) screen 5 340
 (length) (depth to top)
3
 (size) (material)
 - (6) pump 3/4 10
 (HP) (yield gpm)
 (type power)
 - (7) electric log no
 (yes or no)
 (organization running log)
 - (8) how well bottom plugged wash Bottom

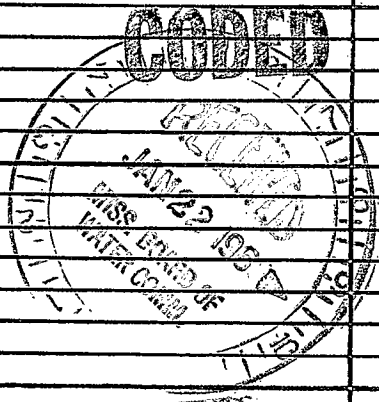

DRILLERS REMARKS:

