

PANOLA
540
1-2-73

MISSISSIPPI
BOARD OF WATER COMMISSIONERS
416 North State Street
Jackson, Mississippi 39201

CODED

WATER WELL DRILLERS LOG

1-2 1973 JAMES R. LIPE PANOLA
date well completed firm name county well located

LANDOWNER: J. W. Hentz
Batesville
Miss.
(mailing address)

description of formations encountered	from	to
Clay	0	20
sand and clay	20	40
sand	40	60
gravel	60	80
sand	80	100
LI	100	158

WELL LOCATION:
sec. 27 T 9 N R 6 E
8 miles S.E. of Batesville
(distance) (direction) (nearest town)

WELL PURPOSE: HOME
(home, irrigation, municipal, industrial)

- WELL COMPLETION DATA:
- (1) diameter (inches) 4"
 - (2) total depth (feet) 158
 - (3) static water level (feet) 80 below top of ground.
 - (4) casing PVC, 148 (material) (depth)
4" (size) if telescope see back.
 - (5) screen 10, 148 (length) (depth to top)
4 (size) PVC (material)
 - (6) pump 3/4, 10 (HP) (yield gpm)
Elec. (type power)
 - (7) electric log NO (yes or no)
NO (organization running log)
 - (8) how well bottom plugged PVC
PIUG


CODED

SEP 8 1973

DRILLERS REMARKS:

If well telescopes please sketch and show depths.

GROUND LEVEL

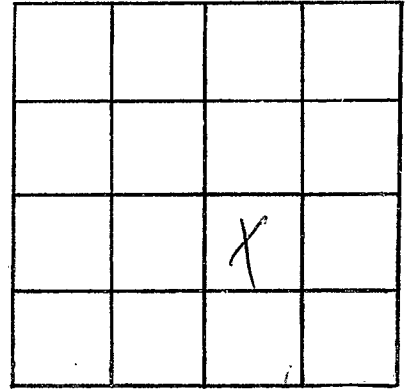

SECTION 27

Please indicate well location X.

ADDITIONAL INFORMATION

If more than one screen,
show locations of each on sketch.