

PANOLA
S44
8-15-73

MISSISSIPPI
BOARD OF WATER COMMISSIONERS
416 North State Street
Jackson, Mississippi 39201

CODED

WATER WELL DRILLERS LOG

8/15 date well completed 1973 firm name Jim Remy county well located Panola

LANDOWNER: Lawrence Tucker
Rte. 1, Box 66
Batesville, Miss
(mailing address)

description of formations encountered	from	to
Clay	0	10
Sand & Gravel	10	20
Sand	20	32

WELL LOCATION:
sec 28 T 9 N R 6 E
7.5 miles East of Batesville
(distance) (direction) (nearest town)

WELL PURPOSE:
x (home/irrigation, municipal, industrial)

- WELL COMPLETION DATA: 8/15/73
- (1) diameter (inches) 2 1/2
 - (2) total depth (feet) 32
 - (3) static water level (feet) 10 (below top of ground)
 - (4) casing (material) PVC (depth) 32
 - (5) screen (length) 10 (depth to top) 22
 - (6) pump (HP) 1/2 (yield gpm) 250
 - (7) electric log (yes or no) no
 - (8) how well bottom plugged B/W


CODED

JAN 25 1974
BOARD OF WATER COMM

DRILLERS REMARKS:

If well telescopes please
sketch and show depths.

GROUND LEVEL

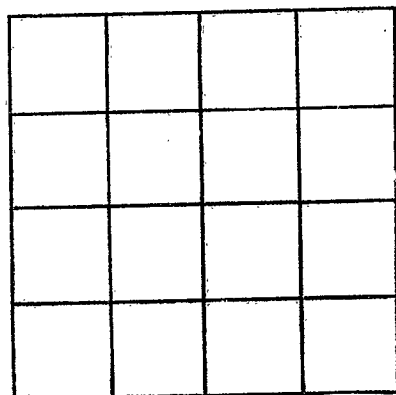

SECTION _____

Please indicate well location X.

ADDITIONAL INFORMATION

If more than one screen,
show locations of each on sketch.