

PANOLA

S45

2-7-74

MISSISSIPPI  
 BOARD OF WATER COMMISSIONERS  
 416 North State Street  
 Jackson, Mississippi 39201

CODED

WATER WELL DRILLERS LOG

2-7

1974 James R. Lipe Well Co.

Panola

date well completed

firm name

county well located

LANDOWNER: Alice

Dunlap

Batesville Miss.

(mailing address)

WELL LOCATION:

sec. 5 T 9 N R 6 E  
 6 miles East of Batesville  
 (distance) (direction) (nearest town)

WELL PURPOSE:

(home) Irrigation, municipal, industrial

WELL COMPLETION DATA:

- (1) diameter (inches) 4
- (2) total depth (feet) 210
- (3) static water level (feet) 90 below top of ground.
- (4) casing PVC, 198  
(material) (depth)  
4 if telescope see back.  
(size)
- (5) screen 12, 198  
(length) (depth to top)  
4, PVC  
(size) (material)
- (6) pump 1 1/2, 20  
(HP) (yield gpm)  
elec.  
(type power)
- (7) electric log no  
(yes or no)  
no  
(organization running log)
- (8) how well bottom plugged PVC  
plug

description of formations encountered

from to

Top soil	0	20
red sand	20	40
" "	40	60
gravel	60	80
black clay	80	100
" "	100	120
sand and clay	120	140
" " "	140	160
sand	160	180
" "	180	200
" "	200	210

CODED


DEPT. OF WATER  
 MAR 5 1974

DRILLERS REMARKS:

MISS. BD. OF WATER COMM

If well telescopes please sketch and show depths.

GROUND LEVEL

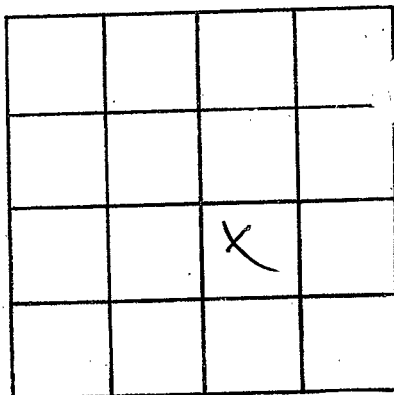

SECTION 5

Please indicate well location X.

ADDITIONAL INFORMATION

If more than one screen, show locations of each on sketch.