

315 Office Road

MISSISSIPPI BOARD OF WATER COMMISSIONERS
416 North State Street
Jackson, Mississippi 39201

CODED

WATER WELL DRILLERS LOG

PANOLA
S 46
1-3-74

Jan 3 1974 J. B. Cain Panola
date well completed firm name county well located
(Big Stream)

LANDOWNER: Mixon

description of formations encountered	from	to
<u>clay</u>	<u>0</u>	<u>20</u>
<u>sand</u>	<u>20</u>	<u>100</u>

(mailing address)

WELL LOCATION:

sec. 35 T 9 N R 6 E
5 miles E of URICKA
(distance) (direction) (nearest town)

WELL PURPOSE:

(home, irrigation, municipal, industrial)

WELL COMPLETION DATA:

- (1) diameter (inches) 4"
- (2) total depth (feet) 100
- (3) static water level (feet) 60 below top of ground.
- (4) casing Plastic 100
(material) (depth)
- (size) If telescope see back.
- (5) screen 10 , 90
(length) (depth to top)
4" , Plastic
(size) (material)
- (6) pump C C
(HP) (yield gpm)
- (type power)
- (7) electric log no
(yes or no)

CODED

(organization running log)

(8) how well bottom plugged Plug


DRILLERS REMARKS:

MADE 20 1974

MISSISSIPPI BOARD OF WATER COMMISSIONERS

If well telescopes please sketch and show depths.

GROUND LEVEL

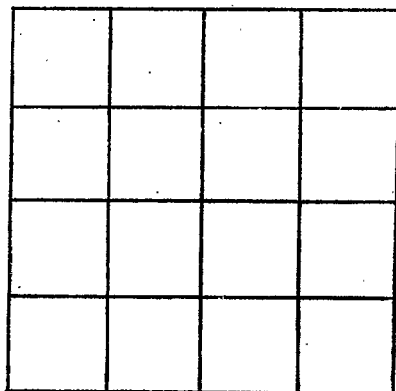

SECTION _____

Please indicate well location X.

ADDITIONAL INFORMATION

If more than one screen,
show locations of each on sketch.