

PANOLA  
 S 47  
 3-14-74

MISSISSIPPI  
 BOARD OF WATER COMMISSIONERS CODED  
 416 North State Street  
 Jackson, Mississippi 39201

WATER WELL DRILLERS LOG

3-14 1974 LiPe well Co. Panola  
 date well completed firm name county well located

LANDOWNER:  
Ira Jenkins  
Batesville Miss.  
 (mailing address)

description of formations encountered	from	to
<u>TOP SOIL</u>	<u>0</u>	<u>20</u>
<u>Sand</u>	<u>20</u>	<u>40</u>
<u>clay</u>	<u>40</u>	<u>60</u>
<u>white sand</u>	<u>60</u>	<u>87</u>

WELL LOCATION:  
 sec 7 T 09 N R 6 E  
8 miles East of Batesville  
 (distance) (direction) (nearest town)

WELL PURPOSE:  
 (home irrigation, municipal, industrial)

- WELL COMPLETION DATA:
- (1) diameter (inches) 4"
  - (2) total depth (feet) 87
  - (3) static water level (feet) 30 below top of ground.
  - (4) casing PVC 77  
 (material) (depth)  
4 if telescope see back.  
 (size)
  - (5) screen 10 77  
 (length) (depth to top)  
4 PVC  
 (size) (material)
  - (6) pump 3/4 10  
 (HP) (yield gpm)  
elec.  
 (type power)
  - (7) electric log no  
 (yes or no)  
no  
 (organization running log)

(8) how well bottom plugged PVC  
plug

DRILLERS REMARKS:


CODED

RECEIVED  
 APR - 3 1974

MISSISSIPPI BOARD OF WATER COMMISSIONERS

If well telescopes please sketch and show depths.

GROUND LEVEL

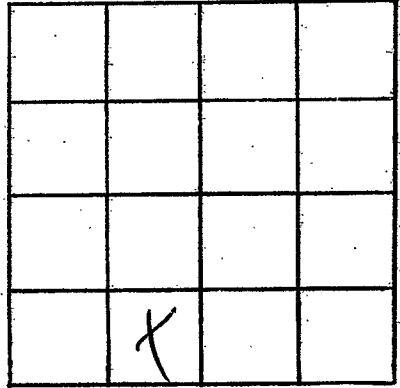

SECTION 4

Please indicate well location X.

ADDITIONAL INFORMATION

If more than one screen, show locations of each on sketch.