

PANOLA
 S 48
 3-28-74

MISSISSIPPI
 BOARD OF WATER COMMISSIONERS
 416 North State Street
 Jackson, Mississippi 39201

CODED

WATER WELL DRILLERS LOG

3-28
 date well completed

1974 Live Well Co
 firm name

Panola
 county well located

LANDOWNER:
 Carl Thompson
 Batesville Miss.
 (mailing address)

description of formations encountered	from	to
Top Soil	0	20
sand	20	67

WELL LOCATION:
 sec 6 T 9 N R 6 E
 10 miles East of Batesville
 (distance) (direction) (nearest town)

WELL PURPOSE:
 (home irrigation, municipal, industrial)

WELL COMPLETION DATA:

(1) diameter (inches) 4

(2) total depth (feet) 67

(3) static water level (feet) 15 below top of ground.

(4) casing PVC 63 (material) (depth)
 4 (size) if telescope see back.

(5) screen 4 63 (length) (depth to top)
 4 PVC (size) (material)

(6) pump 3/4 10 (HP) (yield gpm)
 elec. (type power)

(7) electric log no (yes or no)
 no (organization running log)

(8) how well bottom plugged PVC plug

CODED


RECEIVED
 APR - 3 1974

DRILLERS REMARKS:

MISS. Bd. OF WATER COMMISSIONERS

If well telescopes please sketch and show depths.

GROUND LEVEL

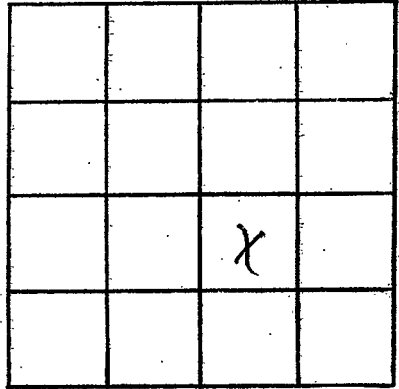

SECTION 6

Please indicate well location X.

ADDITIONAL INFORMATION

If more than one screen,
show locations of each on sketch.