

PANOLA
S 49
3-27-74

MISSISSIPPI
BOARD OF WATER COMMISSIONERS CODED
416 North State Street
Jackson, Mississippi 39201

WATER WELL DRILLERS LOG

3-27 1974 Lipe Well Co. Panola
date well completed firm name county well located


LANDOWNER:	description of formations encountered	from	to
Bobby Phelps Batesville (mailing address)			
	red sand	20	40
	black clay	40	60
	" "	60	80
	" "	80	100
	sand	100	120
	" "	120	140
WELL LOCATION: sec. 1 T. 9 N. R. 6 E. 10 miles East of Batesville (distance) (direction) (nearest town)			
WELL PURPOSE: (home irrigation, municipal, industrial)			
WELL COMPLETION DATA:			
(1) diameter (inches) 4			
(2) total depth (feet) 140			
(3) static water level (feet) 54 below top of ground.			
(4) casing PVC 130 (material) (depth)			
4 (size) if telescope see back.			
(5) screen 10 130 (length) (depth to top)			
4 PVC (size) (material)			
(6) pump 3/4 10 (HP) (yield gpm)			
elec. (type power)			
(7) electric log NO (yes or no)			
NO (organization running log)			
(8) how well bottom plugged PVC PLUG			
DRILLERS REMARKS:			

CODED

APR 2 1974
MISS. BD. OF WATER COMMISSIONERS

If well telescopes please sketch and show depths.

GROUND LEVEL

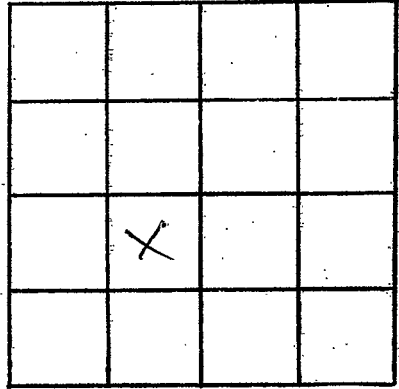

SECTION /

Please indicate well location X.

ADDITIONAL INFORMATION

If more than one screen,
show locations of each on sketch.