

PANOLA  
 550  
 3-27-74

MISSISSIPPI  
 BOARD OF WATER COMMISSIONERS  
 416 North State Street  
 Jackson, Mississippi 39201

CODED

WATER WELL DRILLERS LOG

3-27 1974 Lipe Well Co. Panola  
 date well completed firm name county well located

LANDOWNER: <u>Lula Mae Wilson</u>	description of fomations encountered	from	to
	TOP SOIL	0	20
	sand	20	40
	li	40	79

(mailing address)

WELL LOCATION:  
 sec. 1 T 9 N R 6 E  
 10 miles East of Batesville  
 (distance) (direction) (nearest town)

WELL PURPOSE:  
 (home irrigation, municipal, industrial)

WELL COMPLETION DATA:

- (1) diameter (inches) 4
- (2) total depth (feet) 79
- (3) static water level (feet) 20 below top of ground.
- (4) casing Pvc, 69 (material) (depth)  
4 if telescope see back. (size)
- (5) screen 10, 69 (length) (depth to top)  
4, PVC (size) (material)
- (6) pump 3/4, 10 (HP) (yield gpm)  
elec. (type power)
- (7) electric log no (yes or no)  
no (organization running log)
- (8) how well bottom plugged Pvc Plug

CODED


RECEIVED  
 RECEIVED

APR - 3 1974

DRILLERS REMARKS:

If well telescopes please sketch and show depths.

GROUND LEVEL

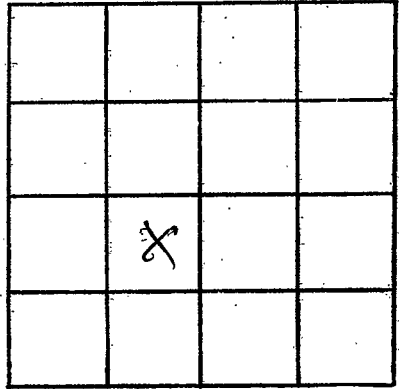

SECTION 1

Please indicate well location X.

ADDITIONAL INFORMATION

If more than one screen, show locations of each on sketch.