

PANOLA  
 S 51  
 3-19-74

MISSISSIPPI  
 BOARD OF WATER COMMISSIONERS  
 416 North State Street  
 Jackson, Mississippi 39201

CODED

WATER WELL DRILLERS LOG

3-19 date well completed      1924 Life well Co. firm name      Panola county well located

| LANDOWNER:        | description of formations encountered | from | to  |
|-------------------|---------------------------------------|------|-----|
| Russell Koonce    | TOP SOIL                              | 0    | 20  |
| Batesville MISS.  | red sand                              | 20   | 40  |
| (mailing address) | clay                                  | 40   | 60  |
|                   | clay                                  | 60   | 80  |
|                   | sand and clay                         | 80   | 100 |
|                   | sand                                  | 100  | 120 |
|                   | clay                                  | 120  | 140 |

| WELL LOCATION:                                   |
|--|
| sec. <u>1</u> T. <u>9</u> N. R. <u>6</u> E.      |
| <u>10</u> miles <u>East</u> of <u>Batesville</u> |
| (distance) (direction) (nearest town)            |

| WELL PURPOSE:                            |
|--|
| (home irrigation, municipal, industrial) |

| WELL COMPLETION DATA:  |
|--|
| (1) diameter (inches) <u>4</u>                                     |
| (2) total depth (feet) <u>140</u>                                  |
| (3) static water level (feet) <u>80</u> below/above top of ground. |
| (4) casing <u>PVC</u> <u>130</u> (material) (depth)                |
| <u>4</u> (size) if telescope see back.                             |
| (5) screen <u>10</u> <u>130</u> (length) (depth to top)            |
| <u>4</u> (size) <u>PVC</u> (material)                              |
| (6) pump <u>3/4</u> <u>10</u> (HP) (yield gpm)                     |
| <u>elec.</u> (type power)  |
| (7) electric log <u>no</u> (yes or no)                             |
| <u>no</u> (organization running log)                               |
| (8) how well bottom plugged <u>PVC</u><br><u>plug</u>              |


| DRILLERS REMARKS: |
|-------------------|
|                   |

CODED

RECEIVED  
 APR 2 1974

If well telescopes please sketch and show depths.

GROUND LEVEL

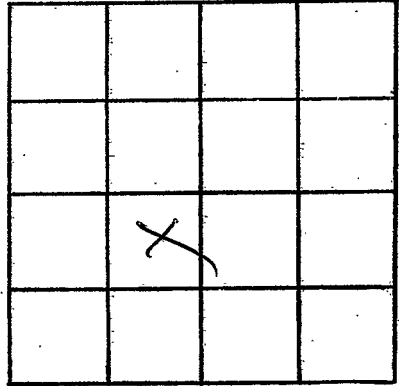

SECTION 1

Please indicate well location X.

ADDITIONAL INFORMATION

If more than one screen, show locations of each on sketch.