

**PANOLA**  
**553**  
**9-24-74**

MISSISSIPPI **CODED**  
 BOARD OF WATER COMMISSIONERS  
 416 North State Street  
 Jackson, Mississippi 39201

**WATER WELL DRILLERS LOG**

9-24 1974 LiPe Well Co Panola  
 date well completed firm name county well located

LANDOWNER:  
AMES ford  
Courtland Miss.  
 (mailing address)

WELL LOCATION:  
 sec. 19 T. 9 N. R. 6 E.  
5 miles N. E. of Courtland  
 (distance) (direction) (nearest town)

WELL PURPOSE:  
 (home) irrigation, municipal, industrial

- WELL COMPLETION DATA:
- (1) diameter (inches) 4
  - (2) total depth (feet) 130
  - (3) static water level (feet) 25 below top of ground.
  - (4) casing PVC, 120  
 (material) (depth)  
4 if telescope see back.  
 (size)
  - (5) screen 10, 120  
 (length) (depth to top)  
4, PVC  
 (size) (material)
  - (6) pump 3/4, 10  
 (HP) (yield gpm)  
elec.  
 (type power)
  - (7) electric log NO  
 (yes or no)  
NO  
 (organization running log)
  - (8) how well bottom plugged PVC  
p 100


description of formations encountered	from	to
Top soil	0	20
sand	20	40
"	40	50
clay	50	60
"	60	80
"	80	100
sand and clay	100	120
sand	120	130

DRILLERS REMARKS:

**RECEIVED**  
**SEP 30 1974**

If well telescopes please sketch and show depths.

GROUND LEVEL

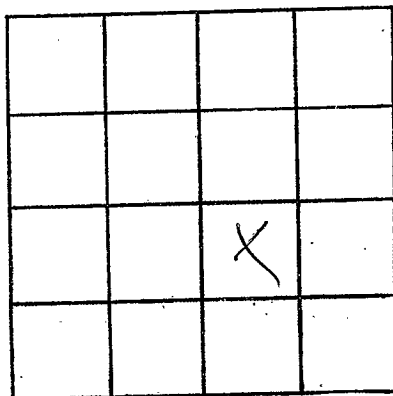

SECTION 19

Please indicate well location X.

ADDITIONAL INFORMATION

If more than one screen, show locations of each on sketch.