

Panola  
S54  
8-1-74

MISSISSIPPI  
 BOARD OF WATER COMMISSIONERS  
 416 North State Street  
 Jackson, Mississippi 39201

CODED

WATER WELL DRILLERS LOG

8-1- 1974 W. G. Mason Panola  
 date well completed firm name county well located

LANDOWNER:  
Lawrence Brothers  
Batesville Miss.  
 (mailing address)

description of formations encountered	from	to
<u>clay fert</u>	<u>0</u>	<u>4</u>
<u>blue clay</u>	<u>4</u>	<u>18</u>
<u>white sand</u>	<u>18</u>	<u>38</u>

WELL LOCATION:  
 sec. 8 T. 9 N. R. 6 E.  
5 miles East of Batesville  
 (distance) (direction) (nearest town)

WELL PURPOSE: FAINT STONE  
 (home, irrigation, municipal, industrial)

- WELL COMPLETION DATA:
- (1) diameter (inches) 4"
  - (2) total depth (feet) 38'
  - (3) static water level (feet) 5' ~~below~~ above top of ground.
  - (4) casing Plastic 28'  
 (material) (depth)  
4"  
 (size) if telescope see back.
  - (5) screen 10' 28'  
 (length) (depth to top)  
4" Plastic  
 (size) (material)
  - (6) pump 1/3 7  
 (HP) (yield gpm)  
electric  
 (type power)
  - (7) electric log No.  
 (yes or no)  
 (organization running log)
  - (8) how well bottom plugged cap

CODED


RECEIVED  
 DEC 27 1974

MISS. BD. OF WATER COMM.

DRILLERS REMARKS:

If well telescopes please sketch and show depths.

GROUND LEVEL

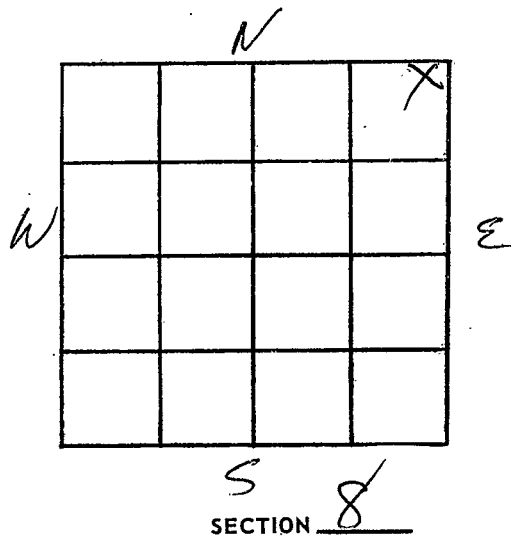

Please indicate well location X.

ADDITIONAL INFORMATION

If more than one screen, show locations of each on sketch.