

PANOLA  
S 55  
8-8-79

MISSISSIPPI  
BOARD OF WATER COMMISSIONERS  
416 North State Street  
Jackson, Mississippi 39201

CODED

WATER WELL DRILLERS LOG

8-8-1974  
date well completed

W. A. Mason  
firm name

Panola  
county well located

LANDOWNER:

Joe Ellis  
Rt. 1, Batesville Miss.  
(mailing address)

description of formations encountered

from to

clay fort 90 12

Red sand 12 60

white sand 60 108

Blue clay at 108

WELL LOCATION:

sec. 16 T 9 N R 6 E  
6 miles East of Batesville  
(distance) (direction) (nearest town)

WELL PURPOSE: Home  
(home, irrigation, municipal, industrial)

CODED

WELL COMPLETION DATA:

(1) diameter (inches) 4"

(2) total depth (feet) 108'

(3) static water level (feet) 98' below top of ground.

(4) casing Plastic, 98'  
(material) (depth)

4" if telescope see back.  
(size)

(5) screen 10' 98'  
(length) (depth to top)

4" Plastic  
(size) (material)


(6) pump 1/3 5  
(HP) (yield gpm)

electric  
(type power)

(7) electric log No  
(yes or no)

(organization running log)

(8) how well bottom plugged Cap

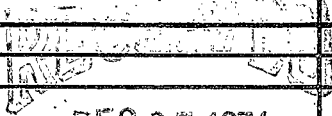


DEC 27 1974

MISS. Bd. OF WATER COMM.

DRILLERS REMARKS:

If well telescopes please sketch and show depths.

GROUND LEVEL

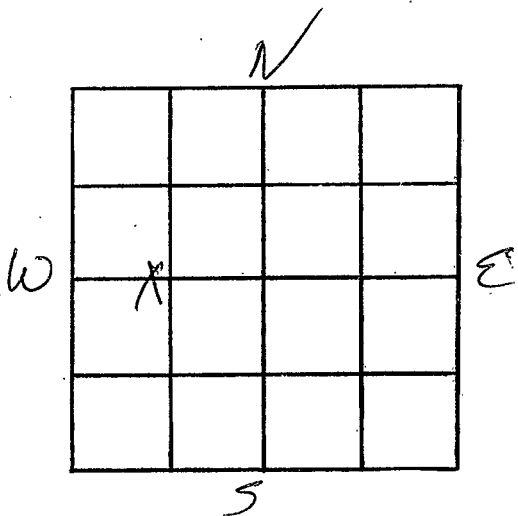

SECTION 16

Please indicate well location X.

ADDITIONAL INFORMATION

If more than one screen, show locations of each on sketch.