

PANOLA
 S 56
 8-16-79

MISSISSIPPI
 BOARD OF WATER COMMISSIONERS
 416 North State Street
 Jackson, Mississippi 39201

WATER WELL DRILLERS LOG

8-16-1979 date well completed
 W.A. Mason firm name
 Panola county well located


LANDOWNER:	description of formations encountered	from	to
Robert Wright	Clay Lert	70	18
PT. 1, Batesville Miss. (mailing address)	gravel	18	60
	white sand	60	100
WELL LOCATION:			
sec. 16 T. 9 N. R. 6 E.			
6 1/2 miles east of Batesville			
WELL PURPOSE: Home (home, irrigation, municipal, industrial)			
WELL COMPLETION DATA:			
CODED			
(1) diameter (inches)	4"		
(2) total depth (feet)	100		
(3) static water level (feet)	78' below top of ground.		
(4) casing (material)	Plastic	(depth)	90'
(size)	4"	if telescope see back.	
(5) screen (length)	10'	(depth to top)	90'
(size)	4"	(material)	Plastic
(6) pump (HP)	1/3	(yield gpm)	7
(type power)	electric		
(7) electric log (yes or no)	No		
(organization running log)			
(8) how well bottom plugged	Cops		
DRILLERS REMARKS:			

MISSISSIPPI
 DEC 27 1974

MISS. BD. OF WATER COMM.

If well telescopes please sketch and show depths.

GROUND LEVEL

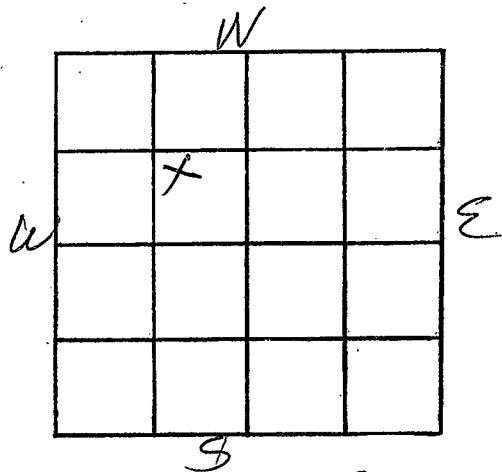

SECTION 1C

Please indicate well location X.

ADDITIONAL INFORMATION

If more than one screen, show locations of each on sketch.