

PANOLA
 S 57
 5-10-74

MISSISSIPPI
 BOARD OF WATER COMMISSIONERS
 416 North State Street
 Jackson, Mississippi 39201

CODE 1

WATER WELL DRILLERS LOG

5-10-1974 date well completed
 W.P. Mason firm name
 Panola county well located

LANDOWNER:
 Poston Ples
 Rt. 1, Batesville Miss
 (mailing address)

description of formations encountered
 Clay dirt from 90 to 8
 Concrete and sand
 & gravel 8 54

WELL LOCATION:
 sec. 27 T 9 N R 6 E
 9 miles SE of Batesville
 (distance) (direction) (nearest town)

hard rock at 54

WELL PURPOSE: Home
 (home, irrigation, municipal, industrial)

WELL COMPLETION DATA:
 (1) diameter (inches) 4"
 (2) total depth (feet) 54'
 (3) static water level (feet) 26' below top of ground.
 (4) casing Plastic, 44' (material) (depth)
 4" If telescope see back. (size)
 (5) screen 10' - 44' (length) (depth to top)
 4" Plastic (size) (material)
 (6) pump 1/3 7 (HP) (yield gpm)
 electric (type power)
 (7) electric log No (yes or no)
 (organization running log)
 (8) how well bottom plugged Cap


CODED
 RECEIVED
 DEC 27 1974

DRILLERS REMARKS:

MISS. DD. OF WATER COM. 11M

If well telescopes please sketch and show depths.

GROUND LEVEL

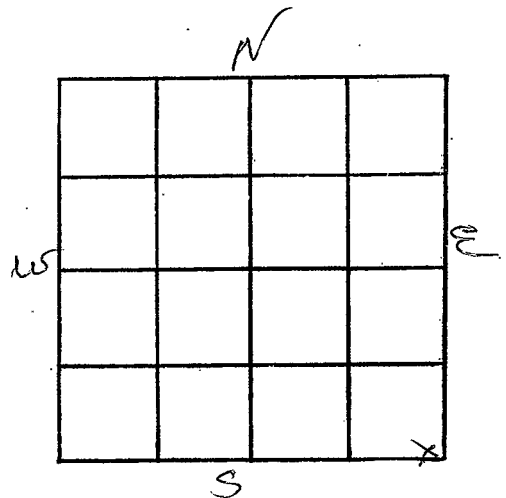

SECTION 27

Please indicate well location X.

ADDITIONAL INFORMATION

If more than one screen, show locations of each on sketch.