

PANOLA
S 58
5-7-74

MISSISSIPPI
BOARD OF WATER COMMISSIONERS
416 North State Street
Jackson, Mississippi 39201

CODED

WATER WELL DRILLERS LOG

5-7-74 date well completed W. Q. Mason firm name Panola county well located

| LANDOWNER: | description of formations encountered | from | to |
|---|---------------------------------------|------|----|
| Russell Palmer | | | |
| Rt. 1 - Batesville Miss. (mailing address) | blue clay | 4 | 20 |
| WELL LOCATION: | gray sand | 20 | 40 |
| sec. 5 T. 9 N. R. 6 E. 4 1/2 miles East of Batesville (distance) (direction) (nearest town) | blue clay | at | 40 |
| WELL PURPOSE: Home (home, irrigation, municipal, industrial) | | | |
| WELL COMPLETION DATA: | | | |
| (1) diameter (inches) 4" | | | |
| (2) total depth (feet) 40' | | | |
| (3) static water level (feet) 3' below top of ground | | | |
| (4) casing (material) (depth) 4" Plastic 20' | | | |
| (5) screen (length) (depth to top) 4" Plastic 20' 20' | | | |
| (6) pump (HP) (yield gpm) 3/4 15 | | | |
| (7) electric log (type power) (yes or no) electric No | | | |
| (8) how well bottom plugged (organization running log) cap | | | |
| DRILLERS REMARKS: | | | |


CODED

DECEMBER 27 1974

MISS. DD. OF WATER COMM.

If well telescopes please sketch and show depths.

GROUND LEVEL

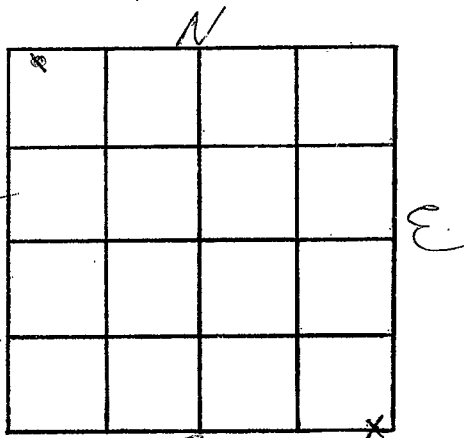

SECTION 5

Please indicate well location X.

ADDITIONAL INFORMATION

If more than one screen, show locations of each on sketch.