

Panola
562
5-5-75

MISSISSIPPI
 BOARD OF WATER COMMISSIONERS
 416 North State Street
 Jackson, Mississippi 39201

WATER WELL DRILLERS LOG CODED

5-5 1975 Life Well Co Panola
 date well completed firm name county well located

LANDOWNER:
James W. Chapman
Courtland, Miss.
 (mailing address)

WELL LOCATION:
 sec. 30 T 9 N R 6 E 15F
 (S) (W)
1/2 miles N East Courtland
 (distance) (direction) of (nearest town)

WELL PURPOSE:
 (home irrigation, municipal, industrial)

- WELL COMPLETION DATA:
- (1) diameter (inches) 4
 - (2) total depth (feet) 97
 - (3) static water level (feet) 60 below above top of ground.
 - (4) casing PVC, 87
 (material) (depth)
4 if telescope see back.
 (size)
 - (5) screen 10, 87
 (length) (depth to top)
4, PVC
 (size) (material)
 - (6) pump 3/4, 10
 (HP) (yield gpm)
elec.
 (type power)
 - (7) electric log NO
 (yes or no)
NO
 (organization running log)
 - (8) how well bottom plugged PVC
cap

description of formations encountered	from	to
Topsoil	0	30
red sand	30	40
sand	40	60
1 "	60	80
1 "	80	97

CODED


Well OK

RECEIVED
 JUL 14 1975

DRILLERS REMARKS:

If well telescopes please sketch and show depths.

GROUND LEVEL

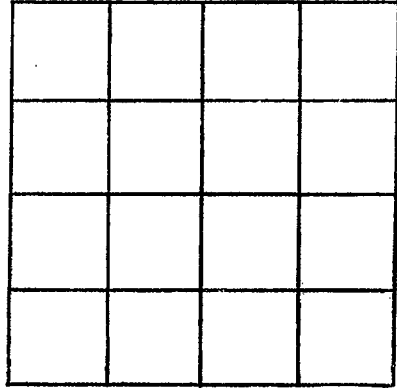

SECTION _____

Please indicate well location X.

ADDITIONAL INFORMATION

If more than one screen, show locations of each on sketch.