

Panola
563
5-16-75

MISSISSIPPI
 BOARD OF WATER COMMISSIONERS
 416 North State Street
 Jackson, Mississippi 39201

CODED

WATER WELL DRILLERS LOG

5-16 1975 Lipe Well Co. Panola
 date well completed firm name county well located

LANDOWNER:	description of formations encountered	from	to
<u>Bobby Baker</u> <u>Batesville Miss.</u> (mailing address)			
	<u>red clay and sand</u>	<u>20</u>	<u>40</u>
	<u>gravel</u>	<u>40</u>	<u>60</u>
	<u>clay</u>	<u>60</u>	<u>80</u>
	<u>clay</u>	<u>80</u>	<u>100</u>
	<u>clay</u>	<u>100</u>	<u>120</u>
	<u>sand</u>	<u>120</u>	<u>140</u>
		<u>140</u>	<u>167</u>


WELL LOCATION:
 sec. 33 T. 9 N. R. 6 E. 15F
9 miles cast of Batesville
 (distance) (direction) (nearest town)

WELL PURPOSE:
 (home, irrigation, municipal, industrial)

WELL COMPLETION DATA:

- (1) diameter (inches) 4
- (2) total depth (feet) 167
- (3) static water level (feet) 90 below above top of ground.
- (4) casing PVC, 157,
(material) (depth)
4 if telescope see back.
(size)
- (5) screen 10, 157
(length) (depth to top)
4, PVC
(size) (material)
- (6) pump 3/4, 10
(HP) (yield gpm)
elec.
(type power)
- (7) electric log no
(yes or no)
no
(organization running log)
- (8) how well bottom plugged PVC
cap

CODED

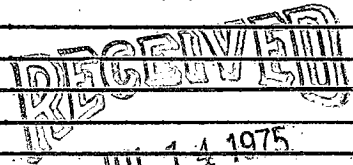


DRILLERS REMARKS:

SD. OF WATER COMMISSIONERS

If well telescopes please sketch and show depths.

GROUND LEVEL

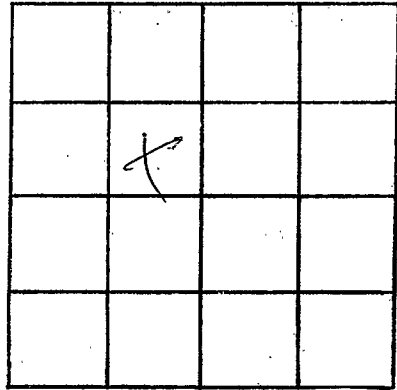

SECTION 53

Please indicate well location X.

ADDITIONAL INFORMATION

If more than one screen,
show locations of each on sketch.