

Panola
 S 64
 9-6-75

MISSISSIPPI
 BOARD OF WATER COMMISSIONERS
 416 North State Street
 Jackson, Mississippi 39201

CODED

WATER WELL DRILLERS LOG

Sept 6 1975 North Miss Well Drilling Panola
 date well completed firm name county well located


LANDOWNER: <u>W.P. Jissell</u>	description of formations encountered	from	to
<u>Batesville Miss</u>			
(mailing address)	<u>sand</u>	<u>0</u>	<u>25</u>
WELL LOCATION: sec. <u>4</u> T <u>9</u> N R. <u>6</u> E ^{15F} <u>7</u> miles <u>E</u> of <u>Batesville</u> (distance) (direction) (nearest town)	<u>Blue clay</u>	<u>25</u>	<u>140</u>
WELL PURPOSE: (home, irrigation, municipal, industrial)	<u>sand</u>	<u>140</u>	<u>165</u>
WELL COMPLETION DATA: (1) diameter (inches) <u>4"</u> (2) total depth (feet) <u>165</u> (3) static water level (feet) <u>100</u> below top of ground. (4) casing <u>Plastic</u> , <u>165</u> (material) (depth) (size) If telescope see back. (5) screen <u>10'</u> , <u>155</u> (length) (depth to top) <u>4'</u> , <u>Plastic</u> (size) (material) (6) pump <u>3/4</u> , <u>15</u> (HP) (yield gpm) <u>Electric</u> (type power) (7) electric log <u>No</u> (yes or no) (organization running log) (8) how well bottom plugged <u>Plug</u>			
DRILLERS REMARKS:			

CODED

OCT - 1 1975
 MISS. RD. OF WATER COMMISSIONERS

If well telescopes please sketch and show depths.

GROUND LEVEL

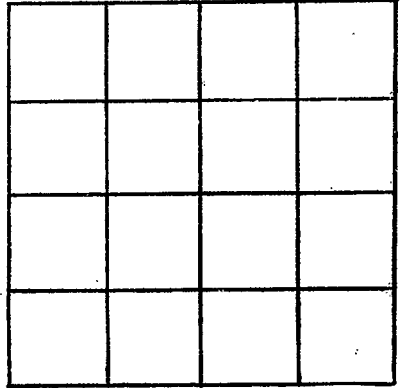

SECTION _____

Please indicate well location X.

ADDITIONAL INFORMATION

If more than one screen, show locations of each on sketch.