

MISSISSIPPI DEPARTMENT OF ENVIRONMENTAL QUALITY

Office of Land and Water Resources

P. O. Box 10631
Jackson, MS 39289-0631
WATER WELL DRILLERS LOG

COUNTY WELL LOCATED PANOLA	
WELL NUMBER 5-66	CODED
DATE WELL COMPLETED 12-5-00	

PERMIT NUMBER HICKS WELL CO.
NAME OF DRILLING FIRM GEORGETOWN, MS 39063

NAME & MAILING ADDRESS OF LANDOWNER Robert Kelly			
100A Public Sq			
Batesville, MS 38606			
WELL LOCATION	SEC	TOWNSHIP	RANGE
	33	9 N	6 E
DISTANCE	DIRECTION	NEAREST TOWN	
5 Miles	SE	of Batesville	
OTHER LANDMARK			
WELL PURPOSE: <u>Home</u> Irrigation, Municipal, Industrial, Fish Pond, etc.			

PUMP DATA		
PUMP TYPE (Circle One): <u>Submersible</u> Turbine, Jet, Flowing Well, Other (Describe) _____		
POWER TYPE (Circle One): <u>Electric</u> Tractor, Diesel, Gasoline, <u>3/4</u> Butane, Other (Describe) _____ H/P _____		
Pump Capacity (GPM) 12	No of Stages	Setting Depth 180 FT.
PUMP TEST		
Well yielded _____ GPM with a drawdown of <u>7.5</u> ft. after _____ hours of pumping		

WELL DATA		
Well Depth 225	Casing Diameter (In) 4	Casing Length (Ft) 205
Type of Casing PVC	Hole Depth 225	Depth to Static Water Level 120
TYPE OF COMPLETION: (Circle One or More): <u>Gravel Packed</u> , Underreamed, Telescoped, Natural Development, Open Hole, Other		
WELL GROUTED TO A DEPTH OF <u>3</u> FEET Type Grout (circle one): Cement, <u>Bentonite</u> , or Mix		

LOG DATA	
TYPE OF LOG RUN (Circle One): <u>No Log Run</u> Electric, Gamma Ray, Density, Sonic, Neutron, Other (Describe) _____	
Name of Organization Running Log	


SCREEN DATA		
Diameter - Inches 4	Length - Feet 20	Slot Size - Inches .013
Screen Type PVC Slotted	Depth to Bottom - Feet 205	

GEOLOGIC DATA (Office Use Only)			
Surface Elev. 121	Geologic Unit MSU 121	Unit Thickness	Depth to Top
Subs. SWL 118	Date	Analysis	Aquifer Test
Driller's Remarks MAR 05 2001			
Dept. of Environmental Quality			
Top of Log Pipe or Reduction in Casings			
FEET		IF TELESCOPED OR MORE THAN ONE SCREEN: USE BACK PAGE	

DESCRIPTION OF FORMATIONS ENCOUNTERED	FROM	TO	FORMATIONS (Continued)	FROM	TO
Beantwhite clay	0	20	Black clay	97	200
Red sand	20	50	White sand	200	225
Gravel	50	95			
Rock	95	97			
IF MORE SPACE IS NEEDED, USE BACK					

If well telescopes please sketch and show depths.

GROUND LEVEL

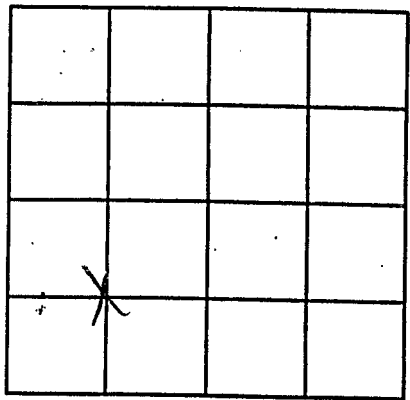

SECTION 33

Please indicate well location X.

ADDITIONAL INFORMATION

Lined area for additional information.

If more than one screen.