

Shot

Panola  
S 2000  
7-6-76

MISSISSIPPI  
BOARD OF WATER COMMISSIONERS  
416 North State Street  
Jackson, Mississippi 39201

WATER WELL DRILLERS LOG

7-6

1976 LIPS Well Co.

Panola

date well completed

firm name

county well located

LANDOWNER:

Evelyn Johnson  
Batesville MS.  
(mailing address)

description of formations encountered

from

to

TOP soil	0	20
red sand	20	40
" "	40	60
CLAY	60	80
" "	80	100
sand and CLAY	100	120
" " "	120	140
" "	140	160
sand	160	179

WELL LOCATION:

sec. 3 T 9 N R 6 E  
10 miles East of Batesville  
(distance) (direction) (nearest town)

WELL PURPOSE:

(home, irrigation, municipal, industrial)

WELL COMPLETION DATA:

- (1) diameter (inches) 4
- (2) total depth (feet) 179
- (3) static water level (feet) 90 below above top of ground.
- (4) casing PVC 169 (material) (depth)  
4 (size) If telescope see back.
- (5) screen 10 169 (length) (depth to top)  
4 PVC (size) (material)
- (6) pump 3/4 10 (HP) (yield gpm)  
ELEC. (type power)
- (7) electric log non (yes or no)  
non (organization running log)
- (8) how well bottom plugged PVC COP


RECEIVED  
AUG 3 1976

DRILLERS REMARKS:

MISS. BD. OF WATER COMM

If well telescopes please sketch and show depths.

GROUND LEVEL

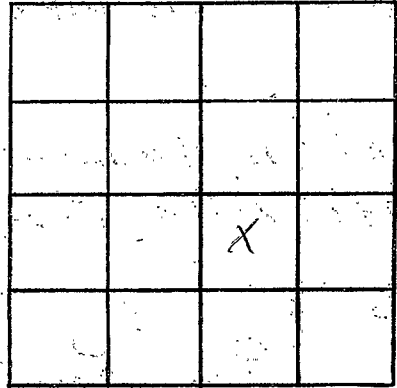

SECTION 3

Please indicate well location X.

ADDITIONAL INFORMATION

If more than one screen,  
show locations of each on sketch.