

PANOLA  
S 2002  
6-1-77

MISSISSIPPI  
BOARD OF WATER COMMISSIONERS  
416 North State Street  
15F Jackson, Mississippi 39201

WATER WELL DRILLERS LOG

6-1 date well completed      1977 Live Well Co. firm name      Panola county well located

LANDOWNER:  
Don Sherman  
Sardis MS.  
(mailing address)

description of formations encountered	from	to
Top soil	0	20
sand	20	80
black clay	80	120
sand and clay	120	160
sand	160	180

WELL LOCATION:  
sec. 2 T 9 N R 6 E  
10 miles East of Batesville  
(distance) (direction) (nearest town)

WELL PURPOSE:  
(home, irrigation, municipal, industrial)

- WELL COMPLETION DATA:
- (1) diameter (inches) 4
  - (2) total depth (feet) 180
  - (3) static water level (feet) 75 below top of ground.
  - (4) casing PVC, 170 (material) (depth)
  - 4 (size) if telescope see back.
  - (5) screen 10, 170 (length) (depth to top)
  - 4, PVC (size) (material)
  - (6) pump 3/4, 10 (HP) (yield gpm)
  - elec. (type power)
  - (7) electric log NON (yes or no)
  - NON (organization running log)
  - (8) how well bottom plugged PVC plug


RECEIVED

JUL 8 - 1977

DRILLERS REMARKS:

If well telescopes please sketch and show depths.

GROUND LEVEL

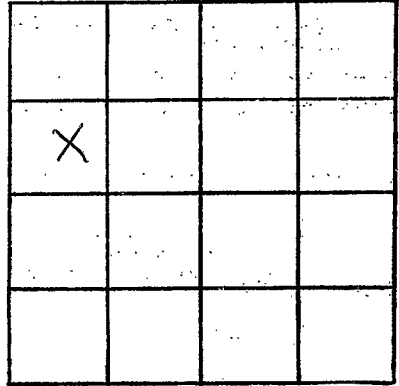

SECTION 2

Please indicate well location X.

ADDITIONAL INFORMATION

Lined area for additional information.

If more than one screen, show locations of each on sketch.