

PANOLA  
S 2005  
6-30-77

MISSISSIPPI  
BOARD OF WATER COMMISSIONERS  
416 North State Street  
Jackson, Mississippi 39201

WATER WELL DRILLERS LOG

6-30 1977 Lipe well Co. Panola  
date well completed firm name county well located

LANDOWNER:	description of formations encountered	from	to
Baker Realty Co.			
Batesville MS. (mailing address)	Gravel	20	90
	Clay	90	120
	Sand and clay	120	160
	Sand	160	180

WELL LOCATION:  
sec. 29 T. 9 N R. 7 E  
S E  
5 miles east of Courtland  
(distance) (direction) (nearest town)

WELL PURPOSE:  
(home, irrigation, municipal, industrial)

- WELL COMPLETION DATA:
- (1) diameter (inches) 4
  - (2) total depth (feet) 180
  - (3) static water level (feet) 80 below top of ground.
  - (4) casing PVC (material) (depth)  
4 If telescope see back. (size)
  - (5) screen 12 168 (length) (depth to top)  
4 PVC (size) (material)
  - (6) pump 3/4 10 (HP) (yield gpm)  
elec. (type power)
  - (7) electric log NON (yes or no)  
NON (organization running log)
  - (8) how well bottom plugged PVC  
PLUG

RECEIVED


III 8 - 1977

DRILLERS REMARKS:

MISSISSIPPI BOARD OF WATER COMMISSIONERS

If well telescopes please sketch and show depths.

GROUND LEVEL

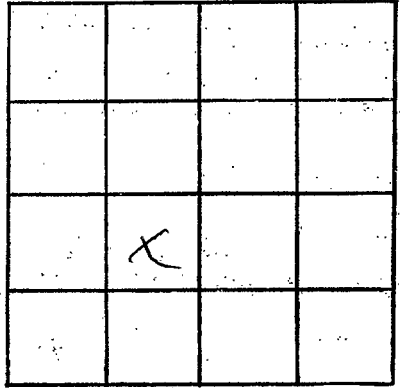

SECTION 29

Please indicate well location X.

ADDITIONAL INFORMATION

If more than one screen, show locations of each on sketch.