

PANOLA
 S 2007
 10-25-77

MISSISSIPPI
 BOARD OF WATER COMMISSIONERS
 416 North State Street
 Jackson, Mississippi 39201

WATER WELL DRILLERS LOG

10-25
 date well completed

15F 77 Lipe well co.
 firm name

Panola
 county well located

LANDOWNER:
 Charles Lagrane
 Batesville MS.
 (mailing address)

description of formations encountered	from	to
Top soil	0	20
red sand	20	40
clay	40	60
" "	60	80
sand and clay	80	100
" " "	100	120
sand	120	160

WELL LOCATION:
 sec. 12 T 9 N R 6 E
 8 miles East of Batesville
 (distance) (direction) (nearest town)

WELL PURPOSE:
 (home) irrigation, municipal, industrial

- WELL COMPLETION DATA:
- (1) diameter (inches) 4
 - (2) total depth (feet) 160
 - (3) static water level (feet) 80 below top of ground.
 - (4) casing PVC 150 (material) (depth)
 - 4 (size) if telescope see back.
 - (5) screen 10 150 (length) (depth to top)
 - 4 PVC (size) (material)
 - (6) pump 3/4 10 (HP) (yield gpm)
 - elec (type power)
 - (7) electric log NO (yes or no)
 - NO (organization running log)
 - (8) how well bottom plugged PVC CAP


RECEIVED

NOV - 7 1977

DRILLERS REMARKS:

If well telescopes please sketch and show depths.

GROUND LEVEL

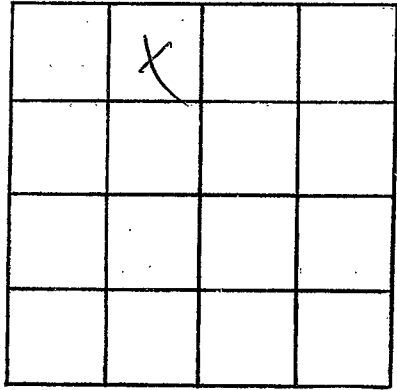

SECTION 12

Please indicate well location X.

ADDITIONAL INFORMATION

Lined area for additional information.

than one screen,
locations of each on sketch.