

PANOLA  
S 2009  
1-22-80

MISSISSIPPI  
BOARD OF WATER COMMISSIONERS  
416 North State Street  
Jackson, Mississippi 39201

WATER WELL DRILLERS LOG

1-22 1980 LIPE Well Co. Panola  
date well completed firm name county well located

LANDOWNER:  
Bobby Griffin  
Batesville, MS.  
(mailing address)

description of formations encountered	from	to
Top soil	0	10
red sand	10	85
white sand	85	120
Clay	120	123

WELL LOCATION:  
sec 36 T 9 N R 6 E  
15 miles S, E. of Batesville  
(distance) (direction) (nearest town)

WELL PURPOSE:  
(home, irrigation, municipal, industrial)

- WELL COMPLETION DATA:
- (1) diameter (inches) 4"
  - (2) total depth (feet) 123'
  - (3) static water level (feet) 80 below top of ground.
  - (4) casing PVC, 119' (material), (depth)  
4" (size) if telescope see back.
  - (5) screen 8', 119' (length), (depth to top)  
4" (size), PVC (material)
  - (6) pump 3/4 (HP), 10 (yield gpm)  
elec. (type power)
  - (7) electric log NO (yes or no)  
NON (organization running log)
  - (8) how well bottom plugged PVC cap


DRILLERS REMARKS:  
4" blank pipe under screen

DEPT. OF NATURAL RESOURCES  
BUREAU OF LAND & WATER RESOURCES

JAN 25 1980  
RECEIVED

If well telescopes please sketch and show depths.

GROUND LEVEL

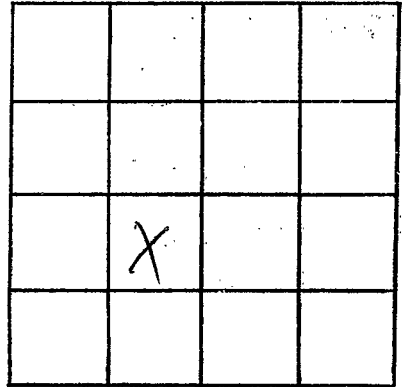

SECTION 36

Please indicate well location X.

ADDITIONAL INFORMATION

If more than one screen, show locations of each on sketch.