

Parola  
5 2011

MISSISSIPPI  
 BOARD OF WATER COMMISSIONERS  
 416 North State Street  
 Jackson, Mississippi 39201

WATER WELL DRILLERS LOG

10-1-04 19 Lipe Well Parola  
 date well completed firm name county well located

LANDOWNER: Seamark Field  
Batesville Ms  
 (mailing address)

WELL LOCATION:  
 sec. 12 T. 9 N R. 6 E  
10 miles E of Batesville  
 (distance) (direction) (nearest town)

WELL PURPOSE: Drone  
 (home, irrigation, municipal, industrial)

- WELL COMPLETION DATA:
- (1) diameter (inches) 4
  - (2) total depth (feet) 160
  - (3) static water level (feet) 80 below top of ground.
  - (4) casing PVC, 150,  
 (material) (depth)  
4 if telescope see back.  
 (size)
  - (5) screen 10, 150  
 (length) (depth to top)  
4, PVC  
 (size) (material)
  - (6) pump 3/4, 11  
 (HP) (yield gpm)  
elec  
 (type power)
  - (7) electric log NO  
 (yes or no)
- (organization running log)
- (8) how well bottom plugged Cap

description of formations encountered	from	to
top soil	0	10
SAND	10	20
clay	20	80
SAND	80	92
Rock	92	
clay	92	130
SAND & clay	130	145
SAND	145	160

DRILLERS REMARKS:


DEPT. OF NATURAL RESOURCES  
 BUREAU OF LAND & WATER RESOURCES

OCT 16 1994

RECEIVED

If well telescopes please  
sketch and show depths.

GROUND LEVEL

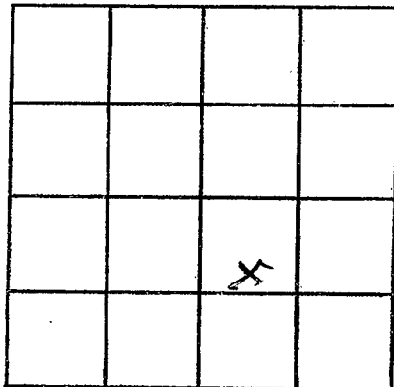

SECTION \_\_\_\_\_

Please indicate well location X.

ADDITIONAL INFORMATION

If more than one screen,  
show locations of each on sketch.