

**MISSISSIPPI DEPARTMENT OF ENVIRONMENTAL QUALITY**  
Bureau of Land and Water Resources

P. O. Box 10631  
Jackson, MS 39289-0631  
**WATER WELL DRILLERS LOG**

COUNTY WELL LOCATED <i>Monroe</i>	
WELL NUMBER <i>2014</i>	CODED
DATE WELL COMPLETED <i>7-8-92</i>	

PERMIT NUMBER <i>POB90 Pope MS</i>
NAME OF DRILLING FIRM <i>Pope Well Supply</i>

NAME & MAILING ADDRESS OF LANDOWNER <i>Mike Wilko</i>		
<i>Rt 1 Box 225-A</i>		
<i>Sards Ms 38664</i>		
WELL LOCATION: / SEC	TOWNSHIP	RANGE
<i>11</i>	<i>9 N</i>	<i>6 E</i>
DISTANCE <i>6</i> Miles	DIRECTION <i>E</i>	NEAREST TOWN <i>B'ville</i>
OTHER LANDMARK		
WELL PURPOSE: <input checked="" type="radio"/> Home, <input type="radio"/> Irrigation, <input type="radio"/> Municipal, <input type="radio"/> Industrial, <input type="radio"/> Fish Pond, etc.		

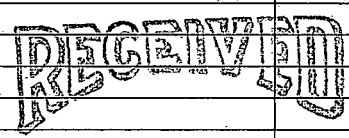
<b>PUMP DATA</b>		
PUMP TYPE (Circle One): <input checked="" type="radio"/> Submersible, <input type="radio"/> Turbine, <input type="radio"/> Jet, <input type="radio"/> Flowing Well, Other (Describe) _____		
POWER TYPE (Circle One): <input checked="" type="radio"/> Electric, <input type="radio"/> Tractor, <input type="radio"/> Diesel, <input type="radio"/> Gasoline, <input type="radio"/> Butane, Other (Describe) _____ H/P _____		
Pump Capacity (GPM) <i>10</i>	No. of Stages	Setting Depth <i>4</i> FT.
PUMP TEST		
Well yielded <i>10</i> GPM with a drawdown of <i>4</i> ft. after <i>2</i> hours of pumping		

<b>WELL DATA</b>		
Well Depth <i>93'</i>	Casing Diameter (In.) <i>4"</i>	Casing Length (Ft.) <i>83</i>
Type of Casing <i>PVC</i>	Hole Depth <i>93</i>	Depth to Static Water Level <i>50'</i>
TYPE OF COMPLETION: (Circle One or More): <input checked="" type="radio"/> Gravel Packed, <input type="radio"/> Underreamed, <input type="radio"/> Telescoped, <input checked="" type="radio"/> Natural Development, <input type="radio"/> Open Hole, <input type="radio"/> Other (Describe) _____		
Top of Lap Pipe or Reduction in Casing		
FEET	IF TELESCOPED OR MORE THAN ONE SCREEN: USE BACK PAGE	

<b>LOG DATA</b>	
TYPE OF LOG RUN (Circle One): <input checked="" type="radio"/> No Log Run, <input type="radio"/> Electric, <input type="radio"/> Gamma Ray, <input type="radio"/> Density, <input type="radio"/> Sonic, <input type="radio"/> Neutron, Other (Describe) _____	
Name of Organization Running Log	

<b>SCREEN DATA</b>		
Diameter - Inches <i>4"</i>	Length - Feet <i>16'</i>	Slot Size - Inches <i>10</i>
Screen Type <i>PVC</i>	Depth to Bottom - Feet <i>93</i>	

<b>GEOLOGIC DATA (Office Use Only)</b>			
Surface Elev.	Geologic Unit	Unit Thickness	Depth to Top
Subs. SWL	Date	Analysis	Aquifer Test
Driller's Remarks			

DESCRIPTION OF FORMATIONS ENCOUNTERED	FROM	TO	FORMATIONS (Continued)	FROM	TO
<i>top soil, hard clay, shell rock, sand</i>	<i>0</i>	<i>20</i>	 <b>JUN 03 1993</b> Dept. of Environmental Quality Office of Land & Water Resources		
<i>sand, streak of shell rock, sand</i>	<i>20</i>	<i>40</i>			
<i>sand w/ some clay, mixed back to clay</i>	<i>40</i>	<i>60</i>			
<i>clay, sand</i>	<i>60</i>	<i>80</i>			
<i>sand</i>	<i>80</i>	<i>93</i>			

IF MORE SPACE IS NEEDED, USE BACK

If well telescopes please  
sketch and show depths.

GROUND LEVEL

X			

SECTION 11

Please indicate well location X.

ADDITIONAL INFORMATION

If more than one screen,  
show location of each on sketch.