

PANOLA  
T1  
7-6-66

MISSISSIPPI BOARD OF WATER COMMISSIONERS

WATER WELL DRILLERS LOG

**CODED**

Date: 7-6, 19 66, Driller: James R. Pipe county Panola  
(When well drilled) (Name) (Where well is located)

(1) Owner of Land: Raul Perkins  
(Name)  
Datesville  
(Address)  
 (2) Location: 8 93 Sec. T2SR5W  
1/4, 1/4, Sec. (Nearest Town)  
8 93 miles, of 8 93  
(distance) (direction) (Nearest Town)  
 (3) Topography: Hilly  
(Hilly) (Flat) (Level)  
 (4) Purpose of Well: dom.  
(Domestic Irrigation Municipal, Industrial, Other)


Description & Color of Materials Sand, Clay, Red Clay, Shell, etc.	Thick- ness Feet	Depth Feet
<u>Clay</u>	<u>0</u>	<u>35</u>
<u>Clay &amp; sand</u>	<u>35</u>	<u>95</u>
<u>Gravel &amp; Sand</u>	<u>95</u>	<u>105</u>
<u>Sand</u>	<u>105</u>	<u>120</u>
<u>up sand</u>	<u>120</u>	<u>144</u>

Information upon completion of well:

(1) Diameter 4 inches.  
 (2) Total Depth 146 feet.  
 (3) Water Level 80 feet below top of ground.  
 (4) Cased to 146, Size 4"  
 (5) Screen: Size 4", Length 6  
 (6) Were any formations sealed against pollution?  
 \_\_\_\_\_ yes, \_\_\_\_\_ no.

**CODED**

If YES depth of formation \_\_\_\_\_  
 Why \_\_\_\_\_  
 Drillers Remarks: \_\_\_\_\_  
 Yield in gpm: \_\_\_\_\_  
 Size pump: \_\_\_\_\_  
 Type power: \_\_\_\_\_

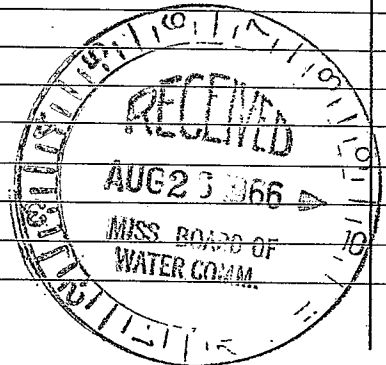

Mail this copy to Board of Water Commissioners 429 Miss. St. Jackson, Miss.

100

100

