

MISSISSIPPI
 BOARD OF WATER COMMISSIONERS
 416 North State Street
 Jackson, Mississippi 39201

CODED

PANOLA
 T 4
 12-12-72

WATER WELL DRILLERS LOG

12-12 date well completed 1972 James B. Lipe firm name Panola county well located

LANDOWNER:
 Shady Grove
 Church, Batesville, Miss.
 (mailing address)

description of formations encountered	from	to
Clay	0	20
Sand	20	40
Clay	40	60
Clay	60	80
Clay	80	100
Sand and Clay	100	120
Clay	120	140
Sand	140	163
Sand and Clay	163	173

WELL LOCATION:
 sec. 8 T 9 N R 5 E
 10 miles East of Batesville
 (distance) (direction) (nearest town)

WELL PURPOSE: Church
 (home, irrigation, municipal, industrial)

WELL COMPLETION DATA:

(1) diameter (inches) 4

(2) total depth (feet) 173

(3) static water level (feet) 80 below top of ground.

(4) casing PVC, 163 (material) (depth)
 4 (size) if telescope see back.

(5) screen 10, 163 (length) (depth to top)
 4, PVC (size) (material)

(6) pump 3/4, 10 (HP) (yield gpm)
 Elec. (type power)

(7) electric log NO (yes or no)
 NO (organization running log)

(8) how well bottom plugged PVC
 PVC


CODED

DEC 28 1972

DRILLERS REMARKS:

If well telescopes please sketch and show depths.

GROUND LEVEL

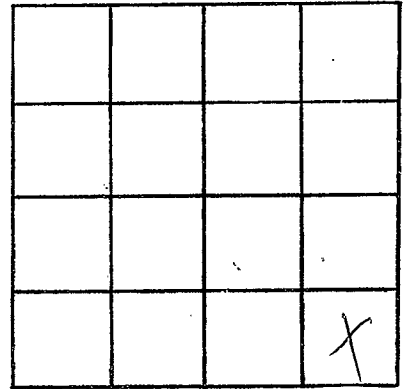

SECTION 8

Please indicate well location X.

ADDITIONAL INFORMATION

If more than one screen,
show locations of each on sketch.