

PANOLA

WATER WELL DRILLERS LOG

CODED

8-11-60

Date: 8-11-60, 1200, Driller: James B. Bipe County Panola

(Name)

(1) Owner of Land: T. E. CRAWLEY

(Name)

BATESVILLE

(Address)

(2) Location: 1/4, 1/4, Sec. 31 T 9 S R 5 W

8 miles S.E. of Batesville

(distance)

(direction)

(Nearest Town)

(3) Topography: (Hilly) (Flat) (Level)

(4) Purpose of Well: Domestic

(Domestic Irrigation, Municipal, Industrial, Other)

Information upon completion of well:

(1) Diameter 20 inches.

(2) Total Depth 114 feet.

(3) Water Level 80 feet below top of ground.

(4) Cased to 105, Size 2

(5) Screen: Size 1/4, Length 6

(6) Were any formations sealed against pollution?


yes, no.

If YES depth of formation

Why

Drillers Remarks:

Description & Color of Materials Sand, Clay, Red Clay, Shell, etc.	Thick- ness Feet	Depth. Feet
clay & gravel	40	40
red clay	30	70
rock & gravel	20	90
con.	10	100
rock	14	114

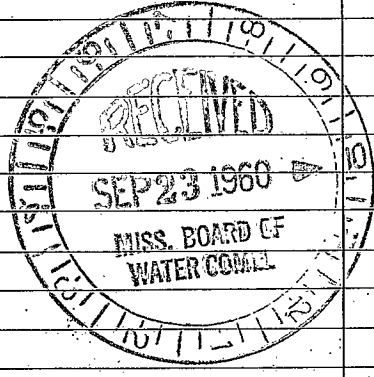

(Use Back Side)

Well No.

