

PANOLA

MISSISSIPPI BOARD OF WATER COMMISSIONERS

R T 7

10-18-61

WATER WELL DRILLERS LOG

(7) EODED

Date: 10/18, 1961, Driller: Jas. R. Lipe

County: Panola

(1) Owner of Land: William Barnes
 (Name)
Batesville, Miss.
 (Address)

(2) Location: 1/4, 1/4, Sec. 3 / T. 9 S. R. 20 W.
9 miles east of Pope
 (distance) (direction) (Nearest Town)

(3) Topography: Hilly
 (Hilly) (Flat) (Level)

(4) Purpose of Well: Domestic
 (Domestic Irrigation
 Municipal, Industrial, Other)

Description & Color of Materials Sand, Clay, Red Clay, Shell, etc.	Thick- ness Feet	Depth Feet
<u>Topsoil & Clay</u>	<u>0</u>	<u>15</u>
<u>Clay</u>	<u>15</u>	<u>30</u>
<u>Clay & gravel</u>	<u>25</u>	<u>55</u>
<u>shale</u>	<u>40</u>	<u>95</u>
<u>blue gravel</u>	<u>12</u>	<u>107</u>
<u>Sand & gravel</u>	<u>90</u>	<u>197</u>
<u>black clay</u>	<u>15</u>	<u>212</u>
<u>passing sand</u>	<u>150</u>	<u>362</u>

Information upon completion of well:

(1) Diameter: 2 inches.

(2) Total Depth: 172 feet.

(3) Water Level: 150 feet below top of ground.


(4) Cased to: 165, Size: 2"

(5) Screen: Size: 1 1/4", Length: 6'

(6) Were any formations sealed against pollution?
 _____ yes, X no.

If YES depth of formation _____
Why _____

Drillers Remarks: _____

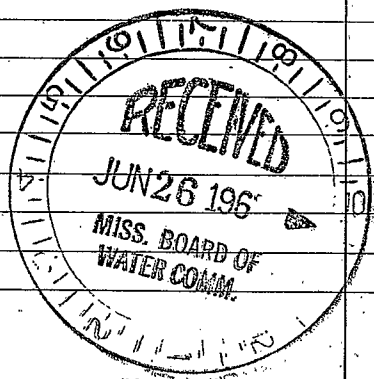

(Use Back Side)

Retain this copy for your office files.

Well No.

